

Winston  
N 13  
12-2-80

MISSISSIPPI  
BOARD OF WATER COMMISSIONERS  
416 North State Street  
Jackson, Mississippi 39201

CODED

WATER WELL DRILLERS LOG

12-2-80 date well completed  
1980 firm name  
The MMS  
Winston county well located

LANDOWNER: Dennis Triplett  
Lewisville, MS  
(mailing address)

WELL LOCATION:  
sec. 12 T. 13 N R. 10 E  
S W  
8 1/2 miles W of Vicksburg  
(distance) (direction) (nearest town)

WELL PURPOSE:  
(home) irrigation, municipal, industrial

WELL COMPLETION DATA:  
(1) diameter (inches) 2  
(2) total depth (feet) 180  
(3) static water level (feet) 90 below above top of ground  
(4) casing PVC 165 (material) (depth) 2 (size) if telescope see back.  
(5) screen 15 165 (length) (depth to top) 2" 10 slot PVC (size) (material)  
(6) pump 1 6 (HP) (yield gpm) Elec. (type power)  
(7) electric log No (yes or no)  
(organization running log)  
(8) how well bottom plugged Joint


| description of formations encountered | from | to  |
|---------------------------------------|------|-----|
| Pipe clay & chalk                     | 0    | 32  |
| Lig wite                              | 32   | 33  |
| Grey & blue chalk                     | 33   | 72  |
| Lig wite                              | 72   | 75  |
| Grey chalk w/ marl                    | 75   | 98  |
| Grey chalk w/ stks                    | 98   | 140 |
| Five Sand                             |      |     |
| Sand Course at Bottom                 | 140  | 180 |

DEPT. OF NATURAL RESOURCES  
BUREAU OF LAND & WATER RESOURCES  
JAN 19 1981  
RECEIVED

DRILLERS REMARKS:

If well telescopes please sketch and show depths.

GROUND LEVEL

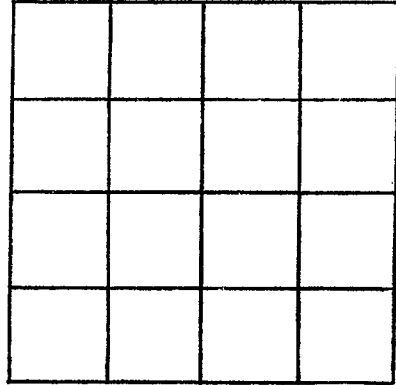

SECTION \_\_\_\_\_

Please indicate well location X.

ADDITIONAL INFORMATION

If more than one screen, show locations of each on sketch.