


If well telescopes please sketch and show depths.

GROUND LEVEL

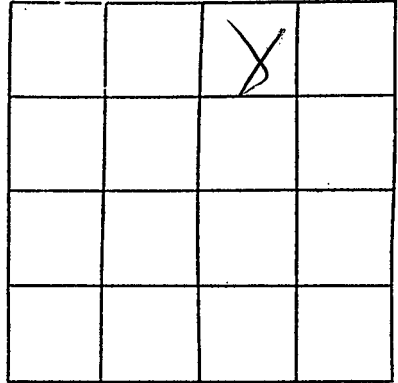

SECTION 25

Please indicate well location X.

| | | | |
|---------------------|---------------|---------------|-----|
| Pump Capacity (GPM) | No. of Stages | Setting Depth | |
| <u>18</u> | <u>10</u> | <u>40</u> | FT. |

PUMP TEST

Well yielded 28 GPM with
a drawdown of 14 ft.
after 1 hours of pumping

LOG DATA

TYPE OF LOG RUN (Circle One): No Log Run,
Electric, Gamma Ray, Density, Sonic, Neutron,
Other (Describe) _____

Name of Organization Running Log

GEOLOGIC DATA (Office Use Only)

| Surface Elev. | Geologic Unit | Unit Thickness | Depth to Top |
|---------------|---------------|----------------|--------------|
| | | | |
| Subs. SWL | Date | Analysis | Aquifer Test |

Driller's Remarks

If more than one screen,
show location of each on sketch.