

Winston  
 N 2000  
 6-20-79

MISSISSIPPI  
 BOARD OF WATER COMMISSIONERS  
 416 North State Street  
 Jackson, Mississippi 39201

WATER WELL DRILLERS LOG

Winston 1979 Thomas & Son Winston  
 date well completed firm name county well located  
 6-20-79

LANDOWNER: Dwight Pope  
 Lewisville, MS  
 (mailing address)

description of formations encountered	from	to
Red D.A.	0	25
Red SAND & GRV	25	26
Fine Grey SAND & CLAY	126	145
Grey-Blue SAND & CLAY	145	330
Red Green SAND	330	370

WELL LOCATION:  
 sec. 14 T 13 N R 10 E  
 S W  
 10 miles SW of Lewisville  
 (distance) (direction) (nearest town)

WELL PURPOSE:  
 (home, irrigation, municipal, industrial)

- WELL COMPLETION DATA:
- (1) diameter (inches) 4
  - (2) total depth (feet) 370
  - (3) static water level (feet) 141 <sup>below</sup>/<sub>above</sub> top of ground.
  - (4) casing PC 300 (material) (depth)  
 2 (size) if telescope see back.
  - (5) screen open (length) (depth to top)  
 (size) (material)
  - (6) pump 2 (HP) 6 (yield gpm)  
 E60 (type power)
  - (7) electric log NO (yes or no)  
 (organization running log)
  - (8) how well bottom plugged open

DRILLERS REMARKS:


Miss. Board of Water Comm.

JUN 27 1979

RECEIVED

If well telescopes please sketch and show depths.

GROUND LEVEL

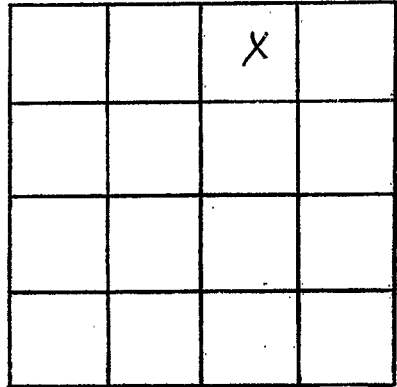

SECTION 14

Please indicate well location X.

ADDITIONAL INFORMATION

If more than one screen,  
show locations of each on sketch.