

WINSTON  
 N 2501  
 11--80

MISSISSIPPI  
 BOARD OF WATER COMMISSIONERS  
 416 North State Street  
 Jackson, Mississippi 39201

WATER WELL DRILLERS LOG

Nov 1980 date well completed      Thomas firm name      Winston county well located

LANDOWNER: OSCAR CATER  
 Rt-1  
 Noxipater, MS.  
 (mailing address)

description of formations encountered	from	to
fine clay	0	16
grey & blue chalk	16	56
sand rock	56	60
CHALK	60	65
dry sand	65	100
course sand	100	170

WELL LOCATION:  
 sec. 7 T. 130<sub>S</sub> R. 10<sub>W</sub>  
 7 1/2 miles NW of Noxipater  
 (distance) (direction) (nearest town)

WELL PURPOSE:  
 (home) irrigation, municipal, industrial

WELL COMPLETION DATA:

(1) diameter (inches) 2" 170 FT

(2) total depth (feet) 170

(3) static water level (feet) 100 (below) above top of ground.

(4) casing PVC 160 (material) (depth)

2 (size) if telescope see back.

(5) screen 10 160 (length) (depth to top)

2 10 slot PVC (size) (material)

(6) pump 1 6 (HP) (yield gpm)

elec. (type power)

(7) electric log No (yes or no)

(organization running log)

(8) how well bottom plugged Pump

DEPT. OF NATURAL RESOURCES  
 BUREAU OF LAND & WATER RESOURCES


JAN 19 1981

RECEIVED

DRILLERS REMARKS:

If well telescopes please sketch and show depths.

GROUND LEVEL

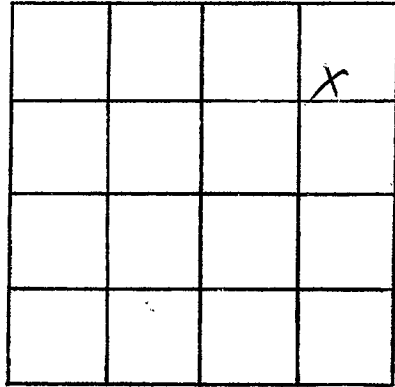

SECTION 2

Please indicate well location X.

ADDITIONAL INFORMATION

A series of horizontal lines for writing additional information.

If more than one screen, show locations of each on sketch.