

MISSISSIPPI
BOARD OF WATER COMMISSIONERS
416 North State Street
Jackson, Mississippi 39201

WATER WELL DRILLERS LOG

WINSTON

WINSTON
N
4-21-81

4-21-81
date well completed

F. O. Conway
firm name

~~WINSTON~~
county well located

LANDOWNER:	description of formations encountered	from	to
Archie Galdames	Red Clay	0	40
Route 8 Box 213	Coarse sand	40	60
Philadelphia, Miss 39 (mailing address)	Blue Clay	60	90
	Cal	90	110
	Black dirt	110	150
	Coarse quartz sand	150	170
	Rock chert	170	200
	FRB Fine sand	200	220
	Rock	220	230

WELL LOCATION:
sec. 24 (T) 13 (N) R 10 (E)
10 miles SW of NOXAPATER (direction) (nearest town)

WELL PURPOSE:
(home, irrigation, municipal, industrial)

- WELL COMPLETION DATA:
- (1) diameter (inches) 2"
 - (2) total depth (feet) 230'
 - (3) static water level (feet) 40' below top of ground.
 - (4) casing (material) 2" (depth) 140'
2" (size) If telescope see back.
 - (5) screen (length) 2" (depth to top) 140'
2" x 4" (size) (material) Shull tract
 - (6) pump (HP) 2 (yield gpm) (220) ?
Elec. (type power) 90W
 - (7) electric log (yes or no) NO
open (organization running log)
 - (8) how well bottom plugged

DEPT. OF NATURAL RESOURCES
BUREAU OF LAND & WATER RESOURCES


APR 23 1981

RECEIVED

DRILLERS REMARKS: Please
Send me some
more water usage
envelope Thanks

If well telescopes please sketch and show depths.

GROUND LEVEL

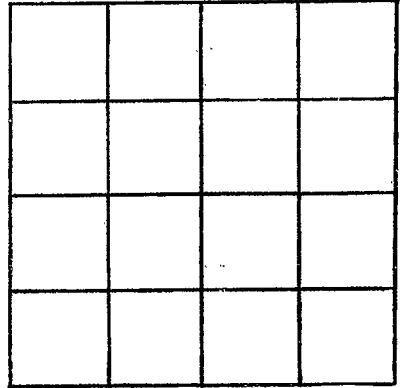

SECTION _____

Please indicate well location X.

ADDITIONAL INFORMATION

If more than one screen, show locations of each on sketch.