

Winston
 No 2003
 10/81

MISSISSIPPI
 BOARD OF WATER COMMISSIONERS
 416 North State Street
 Jackson, Mississippi 39201

WATER WELL DRILLERS LOG

Winston

Oct 29 81 Thomas county well located

| LANDOWNER: | description of formations encountered | from | to |
|--|---------------------------------------|------|-----|
| J. E. McGee | DIRT + Rock | 0 | 14 |
| Rt. 8 | Red SAND | 14 | 16 |
| Phila. MS, | B. DIRT | 16 | 40 |
| (mailing address) | Powder FINE STKS SAND | 40 | |
| WELL LOCATION: | Black + Blue C | | 70 |
| sec. 30 T13 N R10 E | STK W19 | 70 | |
| 13 1/2 miles SW of NOXAPAT | Blue CHALK | 71 | 145 |
| (distance) (direction) (nearest town) | Little Rock + G.C. | 145 | 158 |
| WELL PURPOSE: | HARD ROCK 4" | 158 | |
| (home, irrigation, municipal, industrial) | Grey CHALK | 158 | 162 |
| WELL COMPLETION DATA: | Greenish SAND | 162 | 200 |
| (1) diameter (inches) 2" | | | |
| (2) total depth (feet) 200 | | | |
| (3) static water level (feet) 105 below top of ground. | | | |
| (4) casing 1.58 PVC (material) (depth) | | | |
| 2 (size) if telescope see back. | | | |
| (5) screen open (length) (depth to top) | | | |
| (size) (material) | | | |
| (6) pump 1 (HP) 4 (yield gpm) | | | |
| Elec (type power) | | | |
| (7) electric log NO (yes or no) | | | |
| (organization running log) | | | |
| (8) how well bottom plugged open | | | |
| DRILLERS REMARKS: N.E. of 4 CORNERS 1 mb | | | |


DEPT. OF NATURAL RESOURCES
 BUREAU OF LAND & WATER RESOURCES

DEC 28 1981

RECEIVED

If well telescopes please sketch and show depths.

GROUND LEVEL

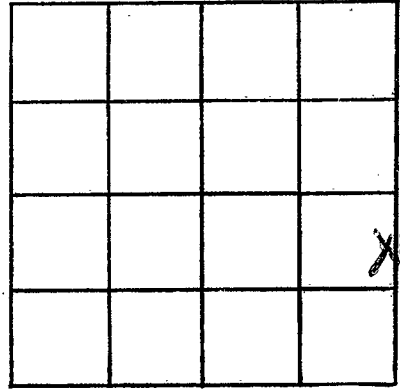

SECTION 30

Please indicate well location X.

ADDITIONAL INFORMATION

If more than one screen,
show locations of each on sketch.