

WINSTON

MISSISSIPPI DEPARTMENT OF NATURAL RESOURCES

Bureau of Land and Water Resources

COUNTY WELL LOCATED
Choctaw

WELL NUMBER
N

CODED

DATE WELL COMPLETED
2005
8-25-87

PERMIT NUMBER

NAME OF DRILLING FIRM
Thomas Drilling

Carthage, MS

P.O. Box 10631
Jackson, Mississippi 39209
WATER WELL DRILLERS LOG

NAME & MAILING ADDRESS OF LANDOWNER
Mike Robertson

Highway 25 N

Kosciusko, MS

WELL LOCATION: SEC TOWNSHIP RANGE
30 **13** **N** **10** **E**
S **W**

DISTANCE DIRECTION NEAREST TOWN
2 Miles **S** of **Howell**

OTHER LANDMARK
Intersection 19 & 25 Highway

WELL PURPOSE: Home, Irrigation, Municipal, Industrial, Fish Pond, etc.
Chicken Houses

PUMP DATA

PUMP TYPE (Circle One):
Submersible, Turbine, Jet, Flowing Well,
Other (Describe) *Air Well*

POWER TYPE (Circle One):
Electric, Tractor, Diesel, Gasoline, Butane,
Other (Describe)

Pump Capacity (GPM) No. of Stages Setting Depth
12 **2 cyl.** **355'** *Air line* FT.

PUMP TEST

Well yielded **12** GPM with
a drawdown of **20** ft.
after **1** hours of pumping

WELL DATA

Well Depth Casing Diameter (In.) Casing Length (Ft.)
370' **2"** **350'**

Type of Casing Hole Depth Depth to Static Water Level
PVC **370'** **150**

TYPE OF COMPLETION: (Circle One or More):
Gravel Packed, Underreamed, Telescoped,
Natural Development, Open Hole, Other
(Describe) *Gravel Packed*

Top of Lap Pipe or Reduction in Casing
— FEET

IF TELESCOPED OR MORE THAN ONE SCREEN: USE BACK PAGE

LOG DATA

TYPE OF LOG RUN (Circle One): *No Log Run*,
Electric, Gamma Ray, Density, Sonic, Neutron,
Other (Describe)

Name of Organization Running Log

SCREEN DATA

Diameter - Inches Length - Feet Slot Size - Inches
2" **20'** **.10**

Screen Type Depth to Bottom - Feet
PVC Wrapped **370'**

GEOLOGIC DATA (Office Use Only)

Surface Elev.	Geologic Unit	Unit Thickness	Depth to Top
Subs. SWL	Date	Analysis	Aquifer Test

Driller's Remarks

DESCRIPTION OF FORMATIONS ENCOUNTERED	FROM	TO
<i>Red dirt</i>	0	3
<i>Sand</i>	3	50
<i>Gray Chalk</i>	50	100
<i>Sandy Chalk</i>	100	200
<i>Chalk</i>	200	300
<i>Sand</i>	300	370

RECEIVED


OCT 13 1987

Department of Natural Resources
Bureau of Land & Water Resources

IF MORE SPACE IS NEEDED, USE BACK

If well telescopes please sketch and show depths.

GROUND LEVEL

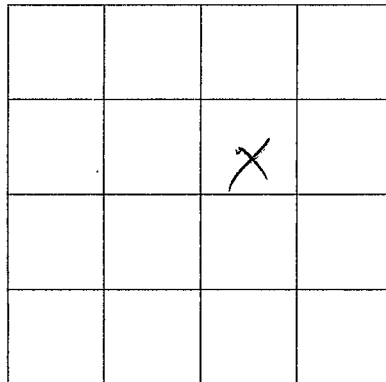

SECTION 30

Please indicate well location X.

ADDITIONAL INFORMATION

If more than one screen,
show location of each on sketch.