

Winston  
 P3  
 8-66

MISSISSIPPI BOARD OF WATER COMMISSIONERS

CODED

3 137  
 WATER WELL DRILLERS LOG

Date: 8-18, 1966, Driller: T. H. Hare County Winston  
 (Name)


(1) Owner of Land: George Howard  
 (Name)  
Rt 1 Noxapater Miss  
 (Address)  
 (2) Location: NE 1/4, SW 1/4, Sec. 18 T33 R1E  
8 miles west of Noxapater  
 (distance) (direction) (Nearest Town)  
 (3) Topography: Hilly  
 (Hilly) (Flat) (Level)  
 (4) Purpose of Well: Home  
 (Domestic Irrigation  
 Municipal, Industrial, Other)

Description & Color of Materials Sand, Clay, Red Clay, Shell, etc.	Thick- ness Feet	Depth Feet
<u>top Soil</u>	<u>2</u>	<u>2</u>
<u>Red clay + Sand</u>	<u>13</u>	<u>15</u>
<u>lignite</u>	<u>3</u>	<u>18</u>
<u>Blue clay</u>	<u>3</u>	<u>21</u>
<u>lignite</u>	<u>1</u>	<u>22</u>
<u>Blue clay</u>	<u>30</u>	<u>52</u>
<u>lignite</u>	<u>1</u>	<u>53</u>
<u>Blue clay</u>	<u>2</u>	<u>55</u>
<u>Green clay + Sand</u>	<u>2</u>	<u>57</u>
<u>Blue Sand</u>	<u>7</u>	<u>64</u>

Information upon completion of well:

(1) Diameter 2 inches.  
 (2) Total Depth 64 feet.  
 (3) Water Level 40 feet below top of ground.  
 (4) Cased to 64, Size 2"  
 (5) Screen: Size 1 1/4, Length 6'  
 (6) Were any formations sealed against pollution?  
 \_\_\_\_\_ yes, ✓ no.

If YES depth of formation \_\_\_\_\_  
 Why \_\_\_\_\_  
 Drillers Remarks: \_\_\_\_\_

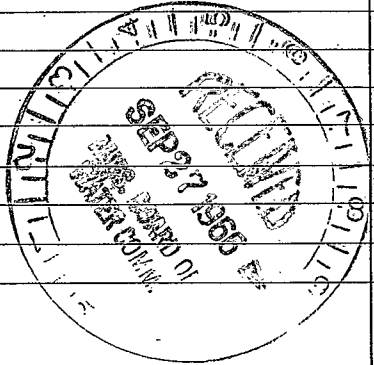

(Use Back Side)

Well No.

