

Winston
 #4
 8-66

MISSISSIPPI BOARD OF WATER COMMISSIONERS

2 131

CODED

WATER WELL DRILLERS LOG

Date: 8-19, 1966, Driller: T. W. Hare County Winston
 (Name)


(1) Owner of Land: Jessie Lee Jones
 (Name)
Rt 1 Noxapater Miss
 (Address)
 (2) Location: NW 1/4, SE 1/4, Sec. 18 T13R1E
8 miles west of Noxapater
 (distance) (direction) (Nearest Town)
 (3) Topography: Hilly
 (Hilly) (Flat) (Level)
 (4) Purpose of Well: Home
 (Domestic Irrigation, Municipal, Industrial, Other)

Description & Color of Materials Sand, Clay, Red Clay, Shell, etc.	Thick- ness Feet	Depth Feet
top soil	2	2
Red clay + sand	6	8
white clay	9	17
lignite	1	18
Blue clay	26	44
lignite	1	45
Blue clay	5	50
yellow clay + sand	5	55
Blue clay	25	80
Blue clay + sand	4	84
Blue sand	2	86
Blue clay	13	99
Blue sand	8	107

Information upon completion of well:

(1) Diameter 2 inches.
 (2) Total Depth 107 feet.
 (3) Water Level 45 feet below top of ground.
 (4) Cased to 107, Size 2"
 (5) Screen: Size 1 1/4, Length 6"
 (6) Were any formations sealed against pollution?
 _____ yes, no.

If YES depth of formation _____
 Why _____
 Drillers Remarks: _____

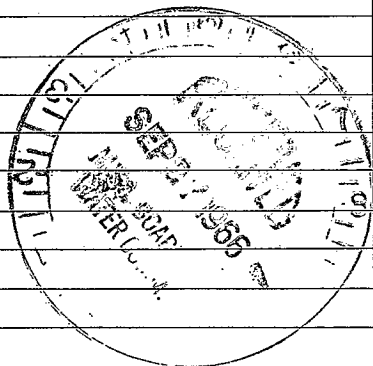

(Use Back Side)

Well No.

