

Winston  
#5  
2-67

MISSISSIPPI BOARD OF WATER COMMISSIONERS


CODED

3 13T

WATER WELL DRILLERS LOG

Date: 2-22, 1967, Driller: J. L. Han County Winston  
(Name)

		Description & Color of Materials Sand, Clay, Red Clay, Shell, etc.	Thick- ness Feet	Depth Feet
(1) Owner of Land: <u>M. M. Hartness</u> (Name)		<u>Red clay</u>	<u>2</u>	<u>2</u>
<u>Nexapates Miss</u> (Address)		<u>light blue clay</u>	<u>4</u>	<u>6</u>
(2) Location: <u>N/2 1/4, N/2 1/4, Sec. 17 T13 R11E</u>		<u>yellow clay + sand</u>	<u>2</u>	<u>8</u>
<u>6</u> miles <u>W</u> of <u>Nexapates</u> (distance) (direction) (Nearest Town)		<u>part tight blue clay</u>	<u>1</u>	<u>9</u>
(3) Topography: <u>Hilly</u> (Hilly) (Flat) (Level)		<u>lignite</u>	<u>1</u>	<u>10</u>
(4) Purpose of Well: <u>House</u> (Domestic Irrigation Municipal, Industrial, Other)		<u>lignite + blue clay</u>	<u>30</u>	<u>40</u>
		<u>yellow clay + sand</u>	<u>6</u>	<u>46</u>
		<u>blue clay + sand</u>	<u>34</u>	<u>80</u>
		<u>blue clay</u>	<u>6</u>	<u>86</u>
		<u>blue clay + sand</u>	<u>8</u>	<u>94</u>
		<u>blue clay</u>	<u>35</u>	<u>129</u>
		<u>green clay</u>	<u>2</u>	<u>131</u>
		<u>blue sand</u>	<u>4</u>	<u>135</u>
		<u>blue clay</u>	<u>10</u>	<u>145</u>
		<u>green clay</u>	<u>5</u>	<u>150</u>
		<u>blue clay + sand</u>	<u>10</u>	<u>160</u>
		<u>blue sand</u>	<u>50</u>	<u>210</u>
Information upon completion of well:				
(1) Diameter <u>2</u> inches.				
(2) Total Depth <u>210</u> feet.				
(3) Water Level <u>105</u> feet below top of ground.				
(4) Cased to <u>147</u> , Size <u>2</u>				
(5) Screen: Size <u>N/A</u> , Length <u>N/A</u>				
(6) Were any formations sealed against pollution? <u>no</u> yes, <u>no</u> no.				
If YES depth of formation _____				
Why _____				
Drillers Remarks:				

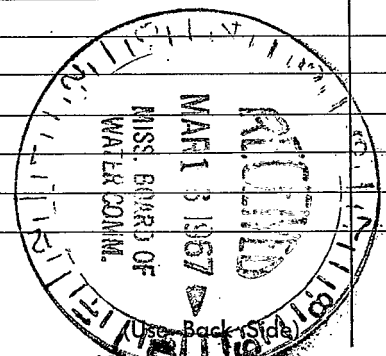

Well No.

