

06

5 13 T

10-19-60

WATER WELL DRILLERS LOG

0302

Date: 10-19, 1960, Driller: J. H. McDonald County Winston

(Name)

(1) Owner of Land: Nettie Wilps
(Name)
Noxapater, Miss.
(Address)
(2) Location: Liberty Common
1/4, 1/4, Sec. T R
8 miles west of Noxapater
(distance) (direction) (Nearest town)
(3) Topography: Level
(Hilly) (Flat) (Level)
(4) Purpose of Well: Domestic
(Domestic Irrigation
Municipal, Industrial, Other)


Description & Color of Materials Sand, Clay, Red Clay, Shell, etc.	Thick- ness Feet	Depth Feet
Red clay	30 ft	30 ft
Black clay	15 ft	45 ft
pipe clay	15 ft	60 ft
sand	20 ft	80 ft

Information upon completion of well:

(1) Diameter 2 inches.
(2) Total Depth 80 feet.
(3) Water Level 50 feet below top of ground.
(4) Cased to 63', Size 2"
(5) Screen: Size 1 1/2" x 1/2", Length 6'
(6) Were any formations sealed against pollution?
no yes, no no.

If YES depth of formation _____
Why _____

Drillers Remarks: _____

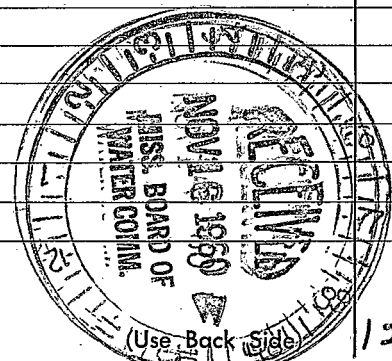

Well No. 12

...the

...the

