


WATER WELL DRILLERS LOG

Date: 2/23/1961, Driller: D.K. Merritt, County Winston

(1) Owner of Land: F.H. Holderness, (Name)
Moxopater, Mass., (Address) 15 13 11
(2) Location: 1/4, 1/4, Sec. 3, T. R.
7 miles S.W., of Moxopater, (Nearest Town)
(3) Topography: (Hilly) (Flat) (Level)
(4) Purpose of Well: Domestic

Table with 3 columns: Description & Color of Materials, Thickness Feet, Depth Feet. Rows include Surge clay sand, Red + white clay, Hard lignite, Med. Hard light blue clay, Med. Hard grey clay, Fine sand + clay, Med. soft grey clay, Soft grey clay cut with, Power sand, Med. Hard grey clay, Soft grey clay, Trace of fine blue sand, Soft grey clay, Fine grey sand, Shale + trace of clay, Med. coarse grey sand.

Information upon completion of well:
(1) Diameter 2 inches.
(2) Total Depth 125 feet.
(3) Water Level 82 feet below top of ground.
(4) Cased to 119, Size 2
(5) Screen: Size 1/4, Length 6'
(6) Were any formations sealed against pollution?
yes, no.

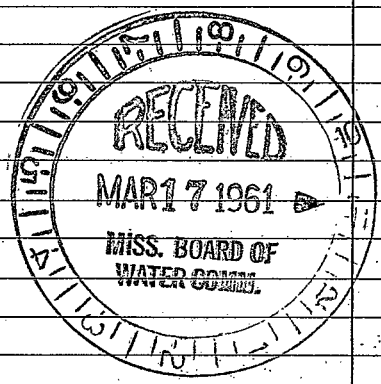

If YES depth of formation
Why
Drillers Remarks: Concrete slab to be poured by owner

(Use Back Side)

Well No.

