

WINSTON

WATER WELL DRILLERS LOG

010

6 131

8-29-61

Date: 8/29/61, 19 Driller: L. K. Merritt County Winston

(Name)

(1) Owner of Land: RAY MANNING (Name)

NOXAPATER MISS. 28 13 11 (Address)

(2) Location: 1/4, 1/4, Sec. T. R.

10 miles SWEST of NOXAPATER (distance) (direction) (Nearest Town)

(3) Topography: (Hilly) (Flat) (Level)

(4) Purpose of Well: DOMESTIC (Domestic Irrigation Municipal, Industrial, Other)

Information upon completion of well:

(1) Diameter 2 inches.

(2) Total Depth 125 feet.

(3) Water Level 42 feet below top of ground.

(4) Cased to 67, Size

(5) Screen: Size OPEN, Length

(6) Were any formations sealed against pollution?


yes, no.

If YES depth of formation 67'

Why To prevent salt sand

Drillers Remarks from filling hole below casing

Description & Color of Materials Sand, Clay, Red Clay, Shell, etc.	Thick- ness Feet	Depth Feet
Surface Clay	8	10
Hard blue clay	10	14
Soft brown clay	14	16
Blue clay, trace		
to fine sand	16	18
Med. fine grey sand	18	28
Fine tan + silt	28	34
Hard lignite	34	35
Med. soft blue clay	35	50
Hard blue clay	50	69
Fine blue sand		
sand, shale +	69	95
Trace of clay		
Hard rock 4' - 4' thick		
Fine blue sand		
shale + clay	95	125
Hard blue clay		
at 125'		

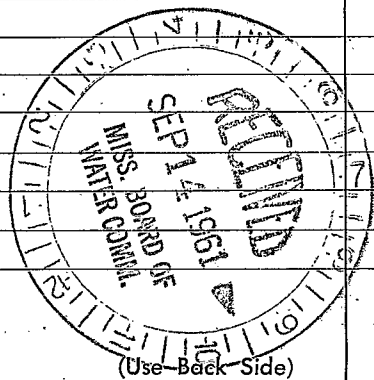

Well No.

