

WINSTON  
 S 015  
 6-68  
 CODED  
 CODED  
 CODED

MISSISSIPPI  
 BOARD OF WATER COMMISSIONERS  
 416 North State Street  
 Jackson, Mississippi 39201

WATER WELL DRILLERS LOG

6-23 date well completed      1968 J. L. Hare firm name      Winston county well located

LANDOWNER: Wade Morris  
 Rt 1 Noyapater  
 miss  
 (mailing address)

WELL LOCATION:  
 sec. 13 T 13 N R 11 E  
 S W  
 4 miles West of Noyapater  
 (distance) (direction) (nearest town)

WELL PURPOSE:  
 (home, irrigation, municipal, industrial)

WELL COMPLETION DATA:

(1) diameter (inches) 2

(2) total depth (feet) 189

(3) static water level (feet) 59 below top of ground.

(4) casing 2 84 (material) (depth)


(5) screen N/A, open well (length) (depth to top)

(6) pump 3/4 5 gal per min (HP) (yield gpm)

(7) electric log NO (yes or no)

(8) how well bottom plugged


description of formations encountered	from	to
top soil	0	2
Red clay	2	7
white clay	7	9
Red sand	9	10
White clay + sand	10	36
Yellow sand	36	37
Blue clay	37	55
Blue clay + sand	55	63
Blue clay	63	74
Hard Blue sand	74	80
Blue clay	80	83
lignite	83	85
Blue clay	85	115
Blue sand	115	120
Blue clay	120	141
Blue sand	141	168
Blue clay	168	170
Blue sand	170	189

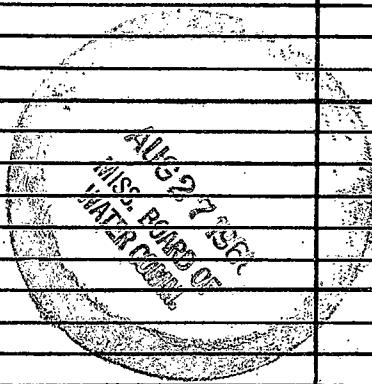

DRILLERS REMARKS:

If well telescopes please  
sketch and show depths.

GROUND LEVEL

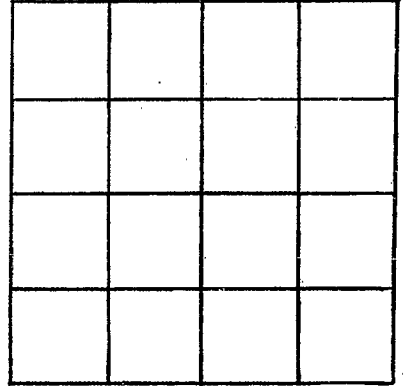

SECTION \_\_\_\_\_

Please indicate well location X.

ADDITIONAL INFORMATION

If more than one screen,  
show locations of each on sketch.