

WINSTON

16

CODED

6 13T

WATER WELL DRILLERS LOG

8-13-63

Date: 8-13, 1963, Driller: MERRITT DRILLING Co. County: WINSTON (Name)

(1) Owner of Land: J. H. CARTER
 (Name)
Louisville, Miss
 (Address)
713-N

(2) Location: 1/4, 1/4, Sec. T R
10 miles West, of Louisville
 (distance) (direction) (Nearest Town)

(3) Topography: Hilly
 (Hilly) (Flat) (Level)

(4) Purpose of Well: Domestic
 (Domestic Irrigation
 Municipal, Industrial, Other)

Description & Color of Materials Sand, Clay, Red Clay, Shell, etc.	Thick- ness Feet	Depth Feet
<u>Red-CLAY</u>	<u>0</u>	<u>2</u>
<u>TAN SAND</u>	<u>2</u>	<u>16</u>
<u>PINK SAND</u>	<u>16</u>	<u>20</u>
<u>COARSE SAND</u>	<u>20</u>	<u>75</u>

Information upon completion of well:

(1) Diameter 2 inches.

(2) Total Depth 75 feet.

(3) Water Level 34 feet below top of ground.

(4) Cased to 63, Size 2"


(5) Screen: Size 2, Length 5'

(6) Were any formations sealed against pollution?
 yes, no.

If YES depth of formation _____

Why _____

Drillers Remarks: _____

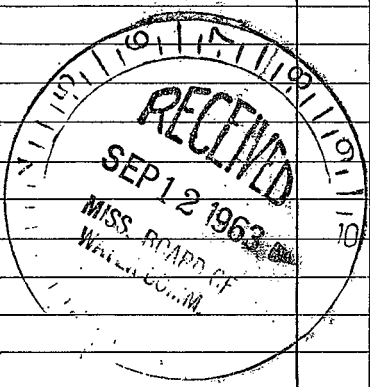

(Use Back Side)

Well No.

