

Φ 22

6 137

CODED

WATER WELL DRILLERS LOG

12-14-65

Date: Dec. 14, 19 65, Driller: Merritt Drilling Co County: WINSTON
 (Name)

(1) Owner of Land: Tommy Young
 (Name)
NOXAPATER, Miss
 (Address) 25 13-11

(2) Location: 1/4, 1/4, Sec. T. R.
5 miles South, of NOXAPATER.
 (distance) (direction) (Nearest Town)

(3) Topography: Hilly
 (Hilly) (Flat) (Level)

(4) Purpose of Well: Domestic
 (Domestic Irrigation
 Municipal, Industrial, Other)

Description & Color of Materials Sand, Clay, Red Clay, Shell, etc.	Thick- ness Feet	Depth Feet
Top Soil	0	2
Red Clay	2	12
Blue sand	12	16
Blue clay	16	55
Rock	55	56
Blue clay	56	62
Blue sand (fine)	62	80
Blue clay	80	162
Rock	162	165
Blue clay + fine sand	165	231
Blue + Grey sand	231	265

Information upon completion of well:

(1) Diameter 2 inches.

(2) Total Depth 265 feet.

(3) Water Level 70 feet below top of ground.


(4) Cased to 252, Size 2"

(5) Screen: Size 1/4, Length 6'

(6) Were any formations sealed against pollution?
 yes, no.

If YES depth of formation
 Why

Drillers Remarks:

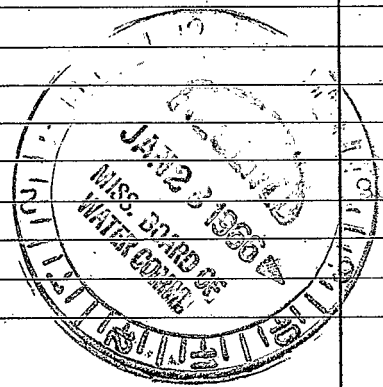

(Use Back Side)

Well No.

Handwritten text, mostly illegible due to fading and bleed-through. Some words like "The" and "of" are visible.

1871

1872

1873

1874

1875

1876

1877

1878

1879

1880