

WINSTON  
 23  
 4-28-71

MISSISSIPPI  
 BOARD OF WATER COMMISSIONERS  
 416 North State Street  
 Jackson, Mississippi 39201

**CODED**

WATER WELL DRILLERS LOG

4-28 1971 JH McDonald Winston  
 date well completed firm name county well located

LANDOWNER: PEMBERGRASS  
HARVEY  
 (mailing address)

description of formations encountered	from	to
Red clay	0	16
sand	16	59

WELL LOCATION:  
 sec. 13 T. 13 N. R. 11 E  
 S W  
 (distance) miles (direction) of (nearest town)

WELL PURPOSE:  
 (home, irrigation, municipal, industrial)

- WELL COMPLETION DATA:
- (1) diameter (inches) 2"
  - (2) total depth (feet) 59
  - (3) static water level (feet) 41 below above top of ground.
  - (4) casing galv. 52  
 (material) (depth)  
~~4"~~ if telescope see back.  
 (size)
  - (5) screen 5' 59 54  
 (length) (depth to top)  
1/4" 6000 SS  
 (size) (material)
  - (6) pump 1 8  
 (HP) (yield gpm)  
electric  
 (type power)
  - (7) electric log no  
 (yes or no)
- (organization running log)
- (8) how well bottom plugged

**CODED**


JUL 1 1971

DRILLERS REMARKS:

MISS. DIV. OF  
 WATER COMMISSIONERS

If well telescopes please sketch and show depths.

GROUND LEVEL

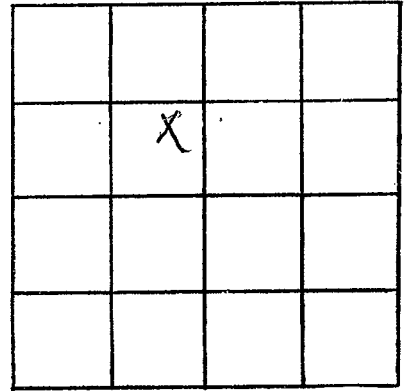

SECTION 13

Please indicate well location X.

ADDITIONAL INFORMATION

If more than one screen,  
show locations of each on sketch.