

WINSTON  
 0024  
 7-15-71

MISSISSIPPI  
 BOARD OF WATER COMMISSIONERS  
 416 North State Street  
 Jackson, Mississippi 39201

**CODED**

WATER WELL DRILLERS LOG

7-15 1971 JH McDaniel Winston  
 date well completed firm name county well located

LANDOWNER: Mose Dailey  
Navasota  
 (mailing address)

description of formations encountered	from	to
Red clay		30
gray clay	30	85
gray sand	85	100

WELL LOCATION:  
 sec. 10 T. 13 N R. 11 E  
 6 miles West of Navasota  
 (distance) (direction) (nearest town)

WELL PURPOSE: Home  
 (home, irrigation, municipal, industrial)

- WELL COMPLETION DATA:
- (1) diameter (inches) 2 1/2"
  - (2) total depth (feet) 100
  - (3) static water level (feet) 75 below top of ground.
  - (4) casing galv. (material) 8 1/2' (depth)  
 (size) if telescope see back.
  - (5) screen 5 (length) 97 92 (depth to top)  
1 1/2 (size) 60 galv. 55 (material)
  - (6) pump 1 1/2 HP (HP) 6 (yield gpm)  
electric (type power)
  - (7) electric log no (yes or no)
  - (organization running log)
  - (8) how well bottom plugged 1

**CODED**


MAY 6 1972

MISS. BD. OF  
 WATER CONTROL

DRILLERS REMARKS:

If well telescopes please sketch and show depths.

GROUND LEVEL

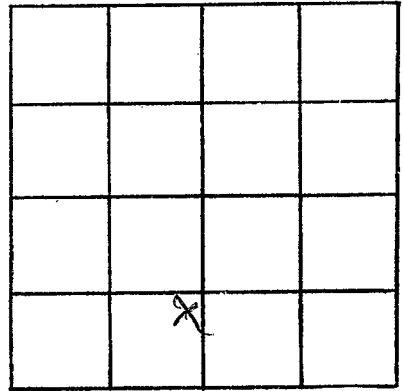

SECTION 10

Please indicate well location X.

ADDITIONAL INFORMATION

If more than one screen,  
show locations of each on sketch.