

WINSTON
 #25
 3-10-72

MISSISSIPPI
 BOARD OF WATER COMMISSIONERS
 416 North State Street
 Jackson, Mississippi 39201

CODED

WATER WELL DRILLERS LOG

3-10 date well completed 19 72 of H McDaniel firm name Winston county well located

LANDOWNER: Joseph. Bates
 Louisville Miss

description of formations encountered

from to

(mailing address)

WELL LOCATION:

sec 6 T-13(N) R-11(E)
 13 miles SW of Louisville
 (distance) (direction) (nearest town)

~~gray clay~~
 pipe clay 25
 gray clay 25 60
 gray sand 60 80

WELL PURPOSE: Home
 (home, irrigation, municipal, industrial)

CODED

WELL COMPLETION DATA:

- (1) diameter (inches) 2"
- (2) total depth (feet) 73
- (3) static water level (feet) 50 below above top of ground.
- (4) casing (material) galv (depth) 63
 2" (size) if telescope see back.
- (5) screen 5 (length) 73 68 (depth to top)
 1/4 (size) 60 galv 55 (material)
- (6) pump 1 (HP) 6 (yield gpm)
 electric (type power)
- (7) electric log no (yes or no)

(organization running log)


(8) how well bottom plugged 0

DRILLERS REMARKS:

MAY 6 1972
 MISS. BOARD OF WATER COMMISSIONERS

If well telescopes please sketch and show depths.

GROUND LEVEL

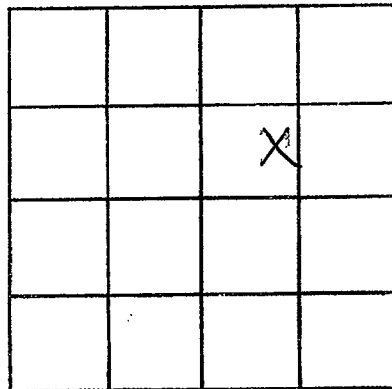

SECTION 6

Please indicate well location X.

ADDITIONAL INFORMATION

If more than one screen,
show locations of each on sketch.