

WINSTON
 26
 2-29-73

MISSISSIPPI
 BOARD OF WATER COMMISSIONERS
 416 North State Street
 Jackson, Mississippi 39201

CODED

WATER WELL DRILLERS LOG

3-29-73 date well completed J H McDonald firm name Winston county well located

LANDOWNER: Percy Clarke
Louisville Miss.

(mailing address)

WELL LOCATION:

sec. 10 T. 13 (N) R. 11 (E)
5 1/2 miles West of Narvada
 (distance) (direction) (nearest town)

WELL PURPOSE: Home
 (home, irrigation, municipal, industrial)

WELL COMPLETION DATA:

- (1) diameter (inches) 2
- (2) total depth (feet) 95
- (3) static water level (feet) 65 below above top of ground.
- (4) casing steel, 84 (material) (depth)
2" if telescope see back. (size)
- (5) screen 5', 90 85 (length) (depth to top)
1/4", 60 gal 55 (size) (material)
- (6) pump 1, 5 (HP) (yield gpm)
electric (type power)
- (7) electric log no (yes or no)

(organization running log)

(8) how well bottom plugged

description of formations encountered	from	to
<u>red clay</u>	<u>0</u>	<u>30</u>
<u>pipe clay</u>	<u>30</u>	<u>50</u>
<u>gray clay</u>	<u>50</u>	<u>80</u>
<u>gray sand</u>	<u>80</u>	<u>95</u>


CODED

DRILLERS REMARKS:

JUL 26 1973

If well telescopes please sketch and show depths.

GROUND LEVEL

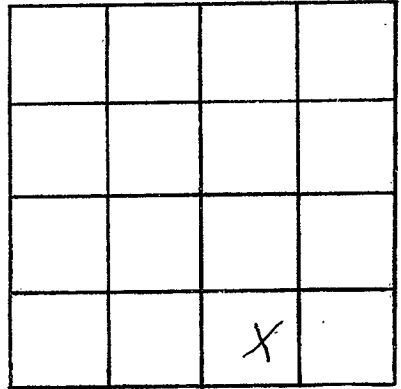

SECTION 10

Please indicate well location X.

ADDITIONAL INFORMATION

If more than one screen,
show locations of each on sketch.