

WINSTON
 029
 9-6-74

MISSISSIPPI
 BOARD OF WATER COMMISSIONERS
 416 North State Street
 Jackson, Mississippi 39201
 WATER WELL DRILLERS LOG

9-6-1974 JH McDonald Winston
 date well completed firm name county well located

LANDOWNER: Bill Tulos
Maropater Miss
 (mailing address)

WELL LOCATION:
 sec. 11 T. 13 (N) R. 11 (E)
 S W
5 1/2 miles West of Maropater
 (distance) (direction) (nearest town)

WELL PURPOSE: Home
 (home, irrigation, municipal, industrial)

- WELL COMPLETION DATA:
- (1) diameter (inches) 2"
 - (2) total depth (feet) 80
 - (3) static water level (feet) 55 below above top of ground.
 - (4) casing PVC, 75'
 (material) (depth)
2" if telescope see back.
 (size)
 - (5) screen 5', 80-75'
 (length) (depth to top)
1/4", 55' 8' slot
 (size) (material)
 - (6) pump 1/2, 3 1/2
 (HP) (yield gpm)
electric
 (type power)
 - (7) electric log no
 (yes or no)
- (organization running log)
- (8) how well bottom plugged _____


description of formations encountered	from	to
	<u>red clay</u>	<u>0</u>
<u>gray clay</u>	<u>25</u>	<u>60</u>
<u>gray</u>	<u>60</u>	<u>80</u>
COUED		

DRILLERS REMARKS:

DEC 15 1974
 DEC - 9 1974
 MISS. Bd. of WATER COMMISSIONERS

If well telescopes please sketch and show depths.

GROUND LEVEL

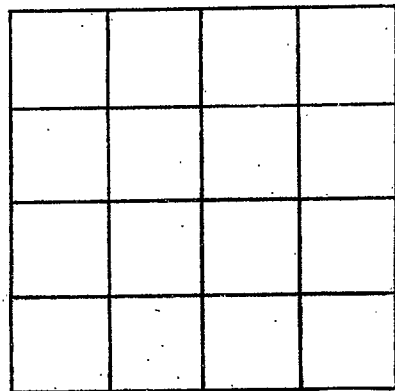

SECTION _____

Please indicate well location X.

ADDITIONAL INFORMATION

If more than one screen, show locations of each on sketch.