

WINSTON
 Ø33
 8-22-75

MISSISSIPPI
 BOARD OF WATER COMMISSIONERS
 416 North State Street
 Jackson, Mississippi 39201

WATER WELL DRILLERS LOG

8-22-1975 *J. H. McDonald* Winston
 date well completed firm name county well located

LANDOWNER: *Tommy Wood*
Louisville, Miss
 (mailing address)

description of formations encountered	from	to
<i>red clay</i>	<i>0</i>	<i>20</i>
<i>sand & clay</i>	<i>20</i>	<i>60</i>
<i>white sand</i>	<i>60</i>	<i>97</i>

WELL LOCATION:
 sec. 5 T 13 (N) R 11 (E)
 S W

(distance) miles (direction) of (nearest town)

WELL PURPOSE:
 (home, irrigation, municipal, industrial)

- WELL COMPLETION DATA:
- (1) diameter (inches) 2
 - (2) total depth (feet) 96
 - (3) static water level (feet) 65 below above top of ground.
 - (4) casing PVC 90
 (material) (depth)
2" if telescope see back.
 (size)
 - (5) screen 6 96 90
 (length) (depth to top)
2 pvc 8 slot
 (size) (material)
 - (6) pump 1 9
 (HP) (yield gpm)
electric
 (type power)
 - (7) electric log no
 (yes or no)

(organization running log)


(8) how well bottom plugged _____

DRILLERS REMARKS:

WINSTON MISSISSIPPI
 1975
 MISS. DEPT. OF WATER CONTROL

If well telescopes please sketch and show depths.

GROUND LEVEL

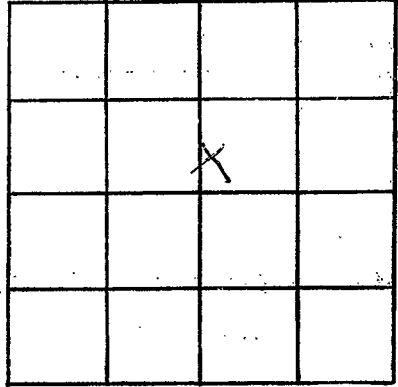

SECTION 5

Please indicate well location X.

ADDITIONAL INFORMATION

If more than one screen, show locations of each on sketch.