


(X)

If well telescopes please sketch and show depths.

GROUND LEVEL

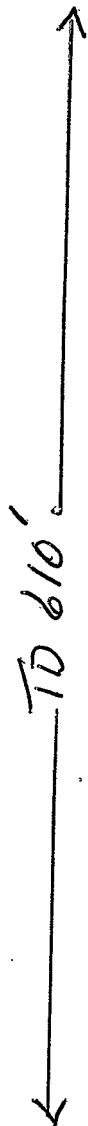

		X	

SECTION 5

Please indicate well location X.

ADDITIONAL INFORMATION

530' STEEL

7 CU YD GRAVEL

4" BRASS

If more than one screen, show locations of each on sketch.