

WINSTON  
 2000  
 4-20-79

MISSISSIPPI  
 BOARD OF WATER COMMISSIONERS  
 416 North State Street  
 Jackson, Mississippi 39201

WATER WELL DRILLERS LOG

4-20-79 date well completed  
 J. H. McDonald firm name  
 Winston county well located

LANDOWNER: Paul Reynolds Gorapaten, Miss	description of formations encountered	from	to
(mailing address)	red clay	0	25
WELL LOCATION: sec. 13 T. 13 N. R. 11 E 4 miles West of Gorapaten (distance) (direction) (nearest town)	sand & pipe clay	25	40
WELL PURPOSE: Home (home, irrigation, municipal, industrial)	yellow sand	40	47
WELL COMPLETION DATA:			
(1) diameter (inches) 2			
(2) total depth (feet) 47			
(3) static water level (feet) 36 below top of ground.			
(4) casing steel, 42 (material) (depth) 2" (size) if telescope see back.			
(5) screen 5' 47 42 (length) (depth to top)			
2" 10 slot (size) (material)			
(6) pump 1/2 W.H. 4 (HP) (yield gpm)			
electric (type power)			
(7) electric log (yes or no)			
(organization running log)			
(8) how well bottom plugged			
DRILLERS REMARKS:			


Miss. Board of Water Comm

JUN 28 1979

RECEIVED

If well telescopes please sketch and show depths.

GROUND LEVEL

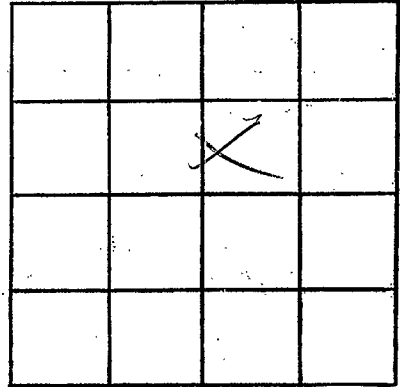

SECTION \_\_\_\_\_

Please indicate well location X.

ADDITIONAL INFORMATION

If more than one screen, show locations of each on sketch.