

MISSISSIPPI DEPARTMENT OF NATURAL RESOURCES
Bureau of Land and Water Resources
 Southport Mall
 P.O. Box 10631
 Jackson, Mississippi 39209
WATER WELL DRILLERS LOG

Winston
0 2002

6-14 1984 Thomas & Son Winston Co
 date well completed firm name county well located

LANDOWNER: Bo Henry
Louisville Mis's
 (mailing address)

WELL LOCATION:
 sec. 34 T. 13 (N) S R. 11 (E) W
8 miles SW of Louisville
 (distance) (direction) (nearest town)

WELL PURPOSE:
 home, irrigation, municipal, industrial

WELL COMPLETION DATA:

(1) diameter (inches) 4"

(2) total depth (feet) 150'

(3) static water level (feet) 74 below above top of ground.

(4) casing 10' 150'
 (material) (depth)

4" if telescope see back.
 (size)

(5) screen 10' 140'
 (length) (depth to top)

4" PVC
 (size) (material)

(6) pump 1 18
 (HP) (yield gpm)

Electric
 (type power)

(7) electric log no
 (yes or no)

(organization running log)

(8) how well bottom plugged Screen

description of formations encountered	from	to
<u>Red Dirt</u>	<u>0</u>	<u>8</u>
<u>Red sand</u>	<u>8</u>	<u>28</u>
<u>yellow sand</u>	<u>28</u>	<u>38</u>
<u>Grey Chalk</u>	<u>38</u>	<u>110</u>
<u>Fine W. sand</u>	<u>110</u>	<u>150</u>

DEPT. OF NATURAL RESOURCES
 BUREAU OF LAND & WATER RESOURCES


JUN 22 1984

DRILLERS REMARKS:

RECEIVED

If well telescopes please sketch and show depths.

GROUND LEVEL

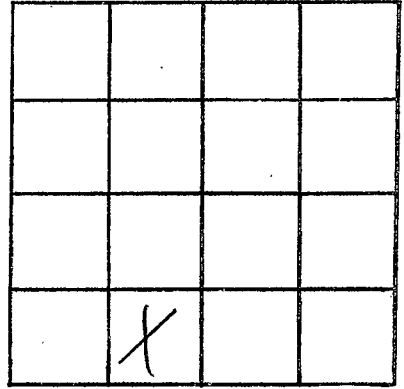

SECTION _____

Please indicate well location X.

ADDITIONAL INFORMATION

If more than one screen;
show locations of each on sketch.