

P-2  
 10-17-60

WATER WELL DRILLERS LOG


Date: 10 17, 1960, Driller: JSMcGovern P 300 County: Winton CO  
 (Name)

(1) Owner of Land: Mrs Madde Blalock  
 (Name)  
 (Address)  
 (2) Location: 1/2 1/4 SE 1/4, Sec. 15 T3R1E  
 1 miles S, of Napoleon  
 (distance) (direction) (Nearest Town)  
 (3) Topography: Hilly  
 (Hilly) (Flat) (Level)  
 (4) Purpose of Well: DOMESTIC  
 (Domestic Irrigation  
 Municipal, Industrial, Other)

Description & Color of Materials Sand, Clay, Red Clay, Shell, etc.	Thick- ness Feet	Depth Feet
Yellow clay	20	
Sandy clay	20	
Red clay	10	
Red Green clay	120	
COLE	10	
Red well	120	
well & R	13	
		343

Information upon completion of well:

(1) Diameter 2 inches.  
 (2) Total Depth 143 feet.  
 (3) Water Level 70 feet below top of ground.  
 (4) Cased to 84, Size 2  
 (5) Screen: Size \_\_\_\_\_, Length \_\_\_\_\_  
 (6) Were any formations sealed against pollution?  
 \_\_\_\_\_ yes, \_\_\_\_\_ no.  
 If YES depth of formation \_\_\_\_\_  
 Why \_\_\_\_\_  
 Drillers Remarks: \_\_\_\_\_

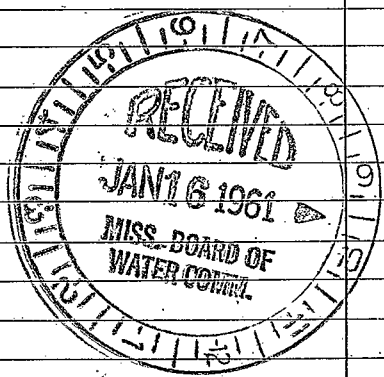

(Use Back Side)

Well No.

