

WINSTON

MISSISSIPPI BOARD OF WATER COMMISSIONERS CODE 1

PA
2-67

3 13T

Corrected
4/24/68

WATER WELL DRILLERS LOG

Date: 2-18, 1967, Driller: J. L. Hame County: Winston
(Name)

(1) Owner of Land: Donald Goodwin
(Name)
Noxapater Miss.
(Address)

(2) Location: SE 1/4, SE 1/4, Sec 23 T3 R12E
3/8 miles S with E of Noxapater
(distance) (direction) (Nearest Town)

(3) Topography: Hilly
(Hilly) (Flat) (Level)

(4) Purpose of Well: Home
(Domestic Irrigation
Municipal, Industrial, Other)

Description & Color of Materials Sand, Clay, Red Clay, Shell, etc.	Thick- ness Feet	Depth Feet
<u>top soil</u>	<u>2</u>	<u>2</u>
<u>Red clay</u>	<u>7</u>	<u>9</u>
<u>Red clay & sand</u>	<u>5</u>	<u>14</u>
<u>pink clay</u>	<u>2</u>	<u>16</u>
<u>pink clay & sand</u>	<u>1</u>	<u>17</u>
<u>white sand</u>	<u>8</u>	<u>25</u>
<u>Sand Rock</u>	<u>1</u>	<u>26</u>
<u>Blue clay - stop</u>		

Information upon completion of well:

(1) Diameter 2 inches.

(2) Total Depth 26 feet.

(3) Water Level 16 feet below top of ground.

(4) Cased to 22, Size 2"


(5) Screen: Size 2, Length 3"

(6) Were any formations sealed against pollution?
_____ yes, N no.

If YES depth of formation _____

Why _____

Drillers Remarks: _____

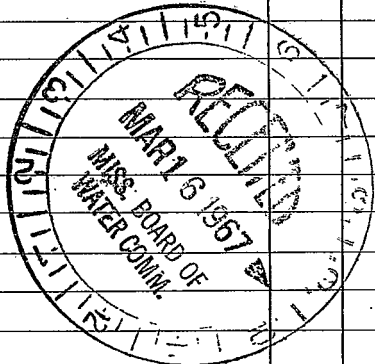

(Use Back Side)

Well No.

