

Winston

MISSISSIPPI BOARD OF WATER COMMISSIONERS

CODED

P5
11-66

3 13T
WATER WELL DRILLERS LOG

Date: 11-2, 1966, Driller: J. L. Hare County: Winston
(Name)

(1) Owner of Land: Kenneth Nation
(Name)
Norapata, Miss
(Address)

(2) Location: SW 1/4, SW 1/4, Sec. 23 T13 R12 E
4 miles SEAST of Norapata
(distance) (direction) (Nearest Town)

(3) Topography: Hilly
(Hilly) (Flat) (Level)

(4) Purpose of Well: None
(Domestic Irrigation
Municipal, Industrial, Other)

Description & Color of Materials Sand, Clay, Red Clay, Shell, etc.	Thick- ness Feet	Depth Feet
top Soil	2	2
Red Clay & Sand	3	5
white Clay	2	7
white clay & Sand	1	8
white clay	10	18
tan clay & Sand	8	26
white clay	10	36
white clay & sand	27	63
tan Sand	7	70
Blue Sand	23	93
Lignite	6	99
gray clay	6	105

Information upon completion of well:

(1) Diameter 2 inches.

(2) Total Depth 105 feet.

(3) Water Level 90 feet below top of ground.

(4) Cased to 63, Size 2.


(5) Screen: Size open, Length _____.

(6) Were any formations sealed against pollution?
_____ yes, no.

If YES depth of formation _____

Why _____

Drillers Remarks: _____

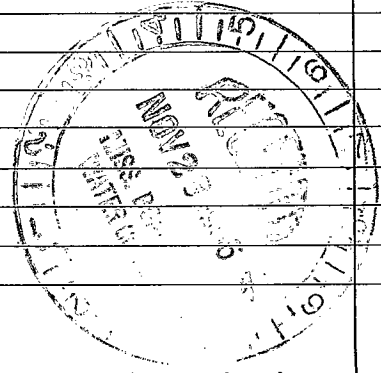

(Use Back Side)

Well No.

