

P 8
10-21-64

5 137

CODED

WATER WELL DRILLERS LOG

Date: 10.21, 1964, Driller: HERRING DRILLING CO County WINSTON
(Name)


(1) Owner of Land: <u>FRANCIS AINSWORTH</u> (Name)	Description & Color of Materials Sand, Clay, Red Clay, Shell, etc.	Thick- ness Feet	Depth Feet
<u>NOXAPATER</u> (Address) <u>14 N E 13-12</u>	<u>Red clay</u>	<u>0</u>	<u>18</u>
(2) Location: <u>1/4</u> , <u>1/4</u> , Sec. <u>14</u> T. <u>13</u> R. <u>12</u>	<u>Red sand</u>	<u>18</u>	<u>36</u>
<u>2</u> miles <u>FAST</u> of <u>NOXAPATER</u> (distance) (direction) (Nearest Town)	<u>Blue clay</u>	<u>36</u>	<u>50</u>
(3) Topography: <u>Hilly</u> (Hilly) (Flat) (Level)	<u>Rock</u>	<u>50</u>	<u>52</u>
(4) Purpose of Well: <u>Domestic</u> (Domestic Irrigation Municipal, Industrial, Other)	<u>Blue Gumbo</u>	<u>52</u>	<u>100</u>
	<u>Fine Blue sand</u>	<u>100</u>	<u>126</u>

Information upon completion of well:

- (1) Diameter 2 inches.
- (2) Total Depth 126 feet.
- (3) Water Level 70 feet below top of ground.
- (4) Cased to 105, Size 2
- (5) Screen: Size Open, Length _____
- (6) Were any formations sealed against pollution?
_____ yes, _____ no.

If YES depth of formation Shale trap
Start at 105
Why _____

Drillers Remarks: _____

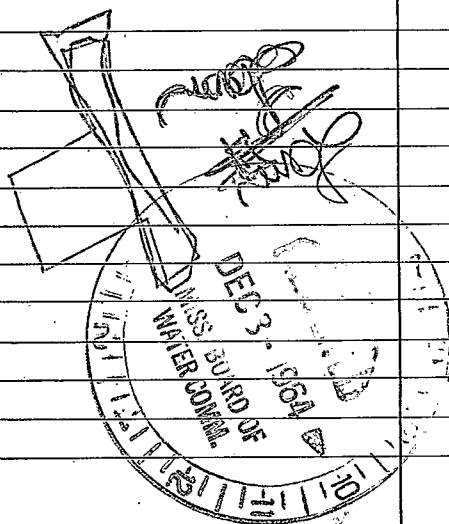

(Use Back Side)

Well No.

100

100

