

P 11
4-22-62

6 13T
WATER WELL DRILLERS LOG

Date: 4/22/62, 19___, Driller: L. K. Merritt County Winston
(Name)


(1) Owner of Land	Description & Color of Materials Sand, Clay, Red Clay, Shell, etc.	Thick- ness Feet	Depth Feet
<u>Taylor</u> <u>Henry Taylor</u> (Name) <u>Novasater</u> <u>Miss</u> (Address) <u>24 13 12</u>	<u>Orange Clay</u>	<u>0</u>	<u>15</u>
(2) Location: ___ 1/4, ___ 1/4, Sec. ___ T. R. ___ <u>5</u> miles <u>S.E.</u> of <u>Novasater</u> (distance) (direction) (Nearest Town)	<u>Red Sand</u>		
(3) Topography: (Hilly) (Flat) (Level)	<u>Red Sand</u>	<u>15</u>	<u>25</u>
(4) Purpose of Well: <u>Domestic</u> (Domestic Irrigation Municipal, Industrial, Other)	<u>Pink Clay Trace</u>		
	<u>to powder sand</u>	<u>25</u>	<u>74</u>
	<u>Dark Blue Clay</u>	<u>74</u>	<u>101</u>
	<u>Mid. Red Blue Clay</u>	<u>101</u>	<u>115</u>
	<u>Powder Sand Trace</u>	<u>115</u>	<u>165</u>
	<u>of Blue Clay</u>		

Information upon completion of well:

- (1) Diameter 2 inches.
- (2) Total Depth 165 feet.
- (3) Water Level _____ feet below top of ground.
- (4) Cased to 126, Size 2
- (5) Screen: Size Open Length _____
- (6) Were any formations sealed against pollution?
✓ yes, _____ no.

If YES depth of formation 2 Traps
Why at 126'

Drillers Remarks:

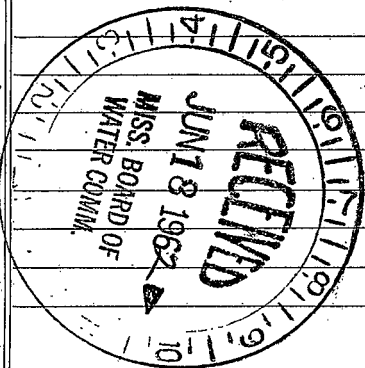

(Use Back Side)

Well No.

