

WINSTON  
P 18  
1-25-73

MISSISSIPPI  
BOARD OF WATER COMMISSIONERS  
416 North State Street  
Jackson, Mississippi 39201

**CODED**

WATER WELL DRILLERS LOG

1-25 date well completed 1973 J H McDonald firm name Winston county well located

LANDOWNER: Earl Yates  
Naxxopater Miss  
(mailing address)

description of formations encountered	from	to
red clay	0	20
red sand	20	35
white	35	55

WELL LOCATION:  
sec. 21 T. 13 N R. 12 E  
1 1/2 miles SE of Naxxopater  
(distance) (direction) (nearest town)

WELL PURPOSE: Home  
(home, irrigation, municipal, industrial)

- WELL COMPLETION DATA:
- (1) diameter (inches) 2
  - (2) total depth (feet) 55
  - (3) static water level (feet) 40 below above top of ground.
  - (4) casing steel 49 (material) (depth)  
2" if telescope see back. (size)
  - (5) screen 4' 54.50 (length) (depth to top)  
1/4" 8 slot SS (size) (material)
  - (6) pump 1 7 (HP) (yield gpm)  
electric (type power)
  - (7) electric log no (yes or no)
  - (8) how well bottom plugged


**CODED**

DRILLERS REMARKS:

JUN 26 1973

If well telescopes please sketch and show depths.

GROUND LEVEL

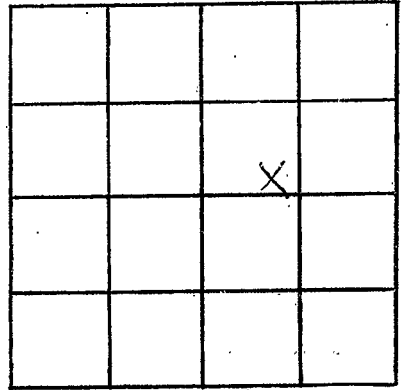

SECTION 21

Please indicate well location X.

ADDITIONAL INFORMATION

If more than one screen,  
show locations of each on sketch.