

WINSTON  
P 19  
1-31-73

MISSISSIPPI  
BOARD OF WATER COMMISSIONERS  
416 North State Street  
Jackson, Mississippi 39201

**CODED**

WATER WELL DRILLERS LOG

1-31-73 date well completed  
J. H. McDonald firm name  
Winston county well located

LANDOWNER: J.A. Higginbotham  
Noxapater Miss

description of formations encountered	from	to
red clay	6	10
white sand	10	32

(mailing address)

WELL LOCATION:  
sec. 21 T. 13 N R. 12 E  
1 1/2 miles SE of Noxapater  
(distance) (direction) (nearest town)

WELL PURPOSE: Home  
(home, irrigation, municipal, industrial)

WELL COMPLETION DATA:

- (1) diameter (inches) 2
- (2) total depth (feet) 32
- (3) static water level (feet) 25 below top of ground.
- (4) casing PVC, 27 (material) (depth)  
2 (size) if telescope see back.
- (5) screen 51 34 3/4 PVC (length) (depth to top)  
2" 8 slot PVC (size) (material)
- (6) pump 1 (HP) 6 (yield gpm)  
electric (type power)
- (7) electric log no (yes or no)
- (8) how well bottom plugged


**CODED**

DRILLERS REMARKS:

JUL 26 1973

If well telescopes please sketch and show depths.

GROUND LEVEL

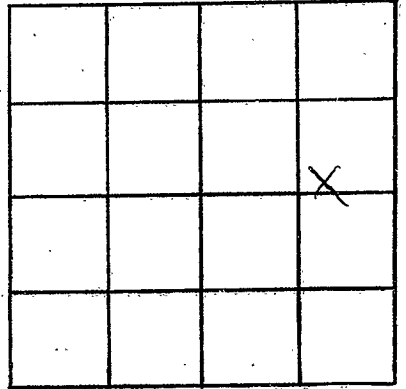

SECTION \_\_\_\_\_

Please indicate well location X.

ADDITIONAL INFORMATION

If more than one screen, show locations of each on sketch.