

WINSTON  
P 20  
9-5-74

MISSISSIPPI  
BOARD OF WATER COMMISSIONERS  
416 North State Street  
Jackson, Mississippi 39201

CODED

WATER WELL DRILLERS LOG

9-5 1974 *H. M. Daniel* *Winston*  
date well completed firm name county well located

LANDOWNER: *Adelle Gregory*  
  
(mailing address)  
  
WELL LOCATION:  
sec. 21 T. 13 N. R. 12 E  
S W  
2 miles South of Napperton  
(distance) (direction) (nearest town)

description of formations encountered	from	to
<i>red clay</i>	<i>0</i>	<i>20</i>
<i>sand</i>	<i>20</i>	<i>40</i>
<i>yellow sand</i>	<i>40</i>	<i>65</i>

WELL PURPOSE: *Home*  
(home, irrigation, municipal, industrial)

- WELL COMPLETION DATA:
- (1) diameter (inches) 2"
  - (2) total depth (feet) 65
  - (3) static water level (feet) 48 below above top of ground.
  - (4) casing PVC, 60  
(material) (depth)  
2" If telescope see back.  
(size)
  - (5) screen 5', 65-60  
(length) (depth to top)  
1 1/2, 8 slot  
(size) (material)
  - (6) pump 1, 6  
(HP) (yield gpm)  
electric  
(type power)
  - (7) electric log no  
(yes or no)
- (organization running log)

CODED


(8) how well bottom plugged \_\_\_\_\_

DRILLERS REMARKS: \_\_\_\_\_

RECEIVED  
MAY 11 1974

If well telescopes please sketch and show depths.

GROUND LEVEL

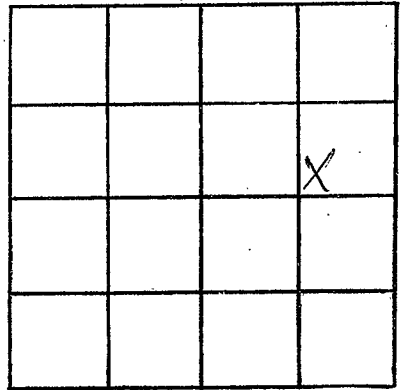

SECTION 21

Please indicate well location X.

ADDITIONAL INFORMATION

If more than one screen,  
show locations of each on sketch.