

WINSTON
P22
T-82
Flig #41

MISSISSIPPI
BOARD OF WATER COMMISSIONERS
416 North State Street
Jackson, Mississippi 39201
WATER WELL DRILLERS LOG

CODED

July 1982 19 Herndon Well & Supply, Inc. Winston
date well completed firm name county well located

LANDOWNER: <u>Town of Noxapater</u>	description of formations encountered	from	to
<u>Noxapater, MS</u>			
	Red Sand	0	35
	Blue Clay w/Streaks of Sand	35	210
	Sandy Clay	210	235
(mailing address)	Blue Clay	235	295
WELL LOCATION:	Sand	295	315
sec. <u>9</u> T. <u>13N</u> N R. <u>12</u> E	Brown Clay	315	354
Inside City limits	Sand	354	363
(distance) miles of (direction) (nearest town)	Blue Clay	363	435
WELL PURPOSE: <u>municipal</u>	Sandy Clay	435	480
(home, irrigation, municipal, industrial)	Sand	480	536
WELL COMPLETION DATA:	Clay	536	548
(1) diameter (inches) <u>8"</u>	Sand	548	570
(2) total depth (feet) <u>525</u>	Sandy Clay	570	610
(3) static water level (feet) <u>160</u> below top of ground.			
(4) casing <u>Steel</u> <u>482</u>			
(material) (depth)			
<u>8"</u> if telescope-see back.			
(size)			
(5) screen <u>40.66</u> <u>482'</u>			
(length) (depth to top)			
<u>4"</u> <u>Stainless Steel</u>			
(size) (material)			
(6) pump <u>15</u> <u>175</u>			
(HP) (yield gpm)			
<u>electric</u>			
(type power)			
(7) electric log <u>yes</u>			
(yes or no)			
MS. <u>Bureau of Geology</u>			
(organization running log)			
(8) how well bottom plugged			
DRILLERS REMARKS:			

CODED

DEPT. OF NATURAL RESOURCES
BUREAU OF LAND & WATER

SEP 20 1982

RECEIVED

(X)

If well telescopes please sketch and show depths.



GROUND LEVEL

482 of 8" pipe

Top of 4" LAP
397'

482'
Top of Screen

Bottom of Screen
522'

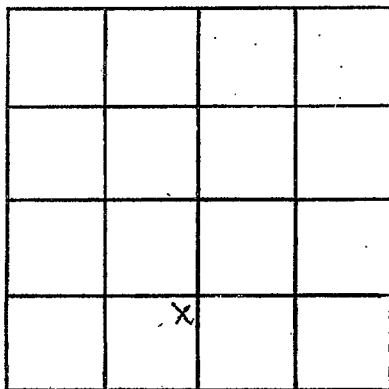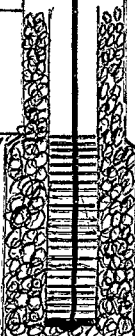

SECTION 9

Please indicate well location X.

ADDITIONAL INFORMATION

A series of horizontal lines for recording additional information.

If more than one screen, show locations of each on sketch.