

MISSISSIPPI DEPARTMENT OF ENVIRONMENTAL QUALITY

Office of Land and Water Resources

P. O. Box 10631
Jackson, MS 39289-0631
WATER WELL DRILLERS LOG

COUNTY WELL LOCATED Winston	
WELL NUMBER P-25	CODED
DATE WELL COMPLETED 7-26-00	

PERMIT NUMBER
NAME OF DRILLING FIRM TIMS Well & Pump Service

NAME & MAILING ADDRESS OF LANDOWNER Janice Atwood			
74 W. Caroline St			
Noxapater, MS 39346			
WELL LOCATION: SEC	TOWNSHIP	RANGE	
9	13	12	(E) (W)
DISTANCE, DIRECTION, NEAREST TOWN 1 1/2 Miles in city limits of Noxapater			
OTHER LANDMARK			
WELL PURPOSE (Circle one): <input checked="" type="radio"/> Home <input checked="" type="radio"/> Irrigation <input type="radio"/> Municipal, Industrial, Fish Pond, etc.			

PUMP DATA		
PUMP TYPE (Circle One): <input checked="" type="radio"/> Submersible <input type="radio"/> Turbine <input type="radio"/> Jet <input type="radio"/> Flowing Well, Other (Describe) _____		
POWER TYPE (Circle One): <input checked="" type="radio"/> Electric <input type="radio"/> Tractor, Diesel, Gasoline, Butane, Other (Describe) _____ H/P 3		
Pump Capacity (GPM) 60	No. of Stages 15	Setting Depth 220' FT.
PUMP TEST		
Well yielded _____ GPM with a drawdown of _____ ft. after _____ hours of pumping		

WELL DATA

Well Depth 368'	Casing Diameter (In.) 4"	Casing Length (Ft.) 348'
Type of Casing PVC	Hole Depth 368'	Depth to Static Water Level
TYPE OF COMPLETION: (Circle One or More): <input checked="" type="radio"/> Gravel Packed <input type="radio"/> Underreamed, Telescoped, Natural Development, Open Hole, Other (Describe): _____		

WELL GROUTED TO A DEPTH OF **8** FEET
Type Grout (circle one): Cement, Bentonite, or Mix

SCREEN DATA

Diameter - Inches 4"	Length - Feet 20'	Slot Size - Inches .010
Screen Type PVC	Depth to Bottom - Feet 368'	

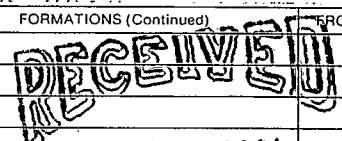
LOG DATA

TYPE OF LOG RUN (Circle One):		No Log Run,
<input type="radio"/> Electric, <input type="radio"/> Gamma Ray, <input type="radio"/> Density, <input type="radio"/> Sonic, <input type="radio"/> Neutron,		Other (Describe) _____
Name of Organization Running Log		

GEOLOGIC DATA (Office Use Only)

Surface Elev.	Geologic Unit	Unit Thickness	Depth to Top
Subs. SWL	Date	Analysis	Aquifer Test
Driller's Remarks			
Top of Lap Pipe or Reduction in Casing			
FEET		IF TELESCOPED OR MORE THAN ONE SCREEN: USE BACK PAGE	

DESCRIPTION OF FORMATIONS ENCOUNTERED	FROM	TO
Red clay & sand	0	20
Pink & red clay	20	60
Dark brown clay	60	200
grey clay	260	280
" "	280	290
silty sand	290	295
clay	295	300
silty sand	300	304
grey clay	304	320
sand	320	368

FORMATIONS (Continued)	FROM	TO
 JAN 22 2001 Dept. of Environmental Quality Office of Land & Water Resources		
IF MORE SPACE IS NEEDED, USE BACK		

If well telescopes please sketch and show depths.

GROUND LEVEL

			X

SECTION _____

Please indicate well location X.

ADDITIONAL INFORMATION

If more than one screen,
show location of each on sketch.