

WINSTON

P 2000

4-8-78

MISSISSIPPI BOARD OF WATER COMMISSIONERS
416 North State Street
Jackson, Mississippi 39201

WATER WELL DRILLERS LOG

11-8-1978 JHM Donald Winston
date well completed firm name county well located

LANDOWNER: J.C. Price
Panopater Miss
(mailing address)
WELL LOCATION:
sec 34 T 13 N R 12 E
5 miles South of Panopater
(distance) (direction) (nearest town)

description of fomations encountered	from	to
red clay	0	25
silty clay	25	40
yellow sand	40	45
gray sand	45	55

WELL PURPOSE: Home
(home, irrigation, municipal, industrial)


WELL COMPLETION DATA:

- (1) diameter (inches) 2 1/2
- (2) total depth (feet) 55
- (3) static water level (feet) 30 below top of ground
- (4) casing steel 40 (material) (depth)
2 1/2 (size) If telescope see back.
- (5) screen 5 14.5-40 (length) (depth to top)
1 1/4 8 slot SS (size) (material)
- (6) pump 1/2 HP Red 3 1/2 (HP) (yield gpm)
Electric (type power)
- (7) electric log No. (yes or no)

(organization running log)


(8) how well bottom plugged

DRILLERS REMARKS:

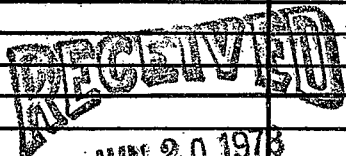

If well telescopes, please sketch and show depths.

GROUND LEVEL

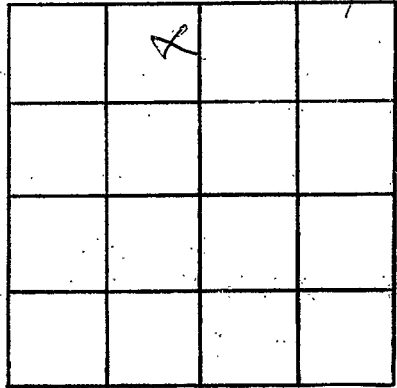

SECTION 34

Please indicate well location X.

ADDITIONAL INFORMATION

If more than one screen,
show locations of each on sketch.