

WINSTON
 P. *2001*
 4-1-78

MISSISSIPPI
 BOARD OF WATER COMMISSIONERS
 416 North State Street
 Jackson, Mississippi 39201

WATER WELL DRILLERS LOG

14-1 1978 *G. H. M. Donald* *Winston*
 date well completed firm name county well located

LANDOWNER: *Henry Clark*
Navapater Miss
 (mailing address)

description of formations encountered	from	to
<i>red clay</i>	<i>0</i>	<i>18</i>
<i>white sand</i>	<i>18</i>	<i>35</i>

WELL LOCATION:
 sec. *34* T. *13* (N) R. *12* (E)
 S W
5 miles *south* of *Navapater*
 (distance) (direction) (nearest town)

WELL PURPOSE: *Home*
 (home, irrigation, municipal, industrial)

WELL COMPLETION DATA:

(1) diameter (inches) *2 1/2*

(2) total depth (feet) *34*

(3) static water level (feet) *26* below top of ground.

(4) casing *steel* *29*
 (material) (depth)
2 1/2 If telescope see back.
 (size)

(5) screen *5* *34* *29*
 (length) (depth to top)
1/4-10-slot SS
 (size) (material)

(6) pump *1/2-Rod* *4*
 (HP) (yield gpm)

electric
 (type power)

(7) electric log *no*
 (yes or no)

(organization running log)

(8) how well bottom plugged _____


DRILLERS REMARKS:

RECEIVED
 JUN 20 1978

MISS. BD. OF WATER COMM

If well telescopes please sketch and show depths.

GROUND LEVEL

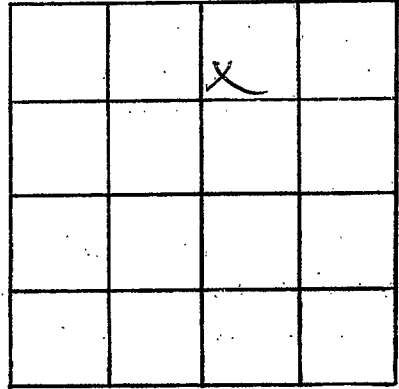

SECTION 34

Please indicate well location X.

ADDITIONAL INFORMATION

If more than one screen, show locations of each on sketch.