

MISSISSIPPI DEPARTMENT OF NATURAL RESOURCES

Bureau of Land and Water Resources

Southport Mall

P.O. Box 10631

Jackson, Mississippi 39209

WATER WELL DRILLERS LOG

WINSTON
P 2003

4-24 1986 Smiths well Drilling WINSTON
date well completed firm name county well located

LANDOWNER: John Holton

description of formations encountered

from to

Top Soil	0	8
Blue Clay	8	90
Blue clay & sand	90	225

(mailing address)

WELL LOCATION:

sec. 2 T 13 N R 12 E
S W

1 miles W of noxpaten
(distance) (direction) (nearest town)

WELL PURPOSE:

(home) Irrigation, municipal, industrial)

WELL COMPLETION DATA:

(1) diameter (inches) 2

(2) total depth (feet) 225

(3) static water level (feet) 40 (below above top of ground)

(4) casing PVC, 140
(material) (depth)

(size) if telescope see back.

(5) screen (length) (depth to top)

(size) (material)

(6) pump 1 6
(HP) (yield gpm)

E (type power)

(7) electric log (yes or no)

(organization running log)

(8) how well bottom plugged open


RECEIVED
MAY 7 1986

DRILLERS REMARKS:

Department of Natural Resources
Bureau of Land & Water Resources

If well telescopes please
sketch and show depths.

GROUND LEVEL

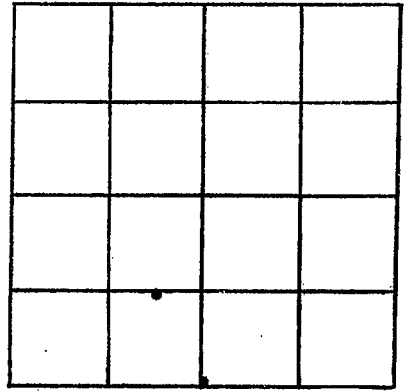

SECTION _____

Please indicate well location X.

ADDITIONAL INFORMATION

If more than one screen,
show locations of each on sketch.