

MISSISSIPPI BOARD OF WATER COMMISSIONERS

Q 2

COPED

WATER WELL DRILLERS LOG

Date: 8/29/62 1962, Driller: Lo K. Muritt County Newton
 (Name)


(1) Owner of Land: Ota Helton
 (Name)
Lanierville Miss
 (Address) 21 1313
 (2) Location: 1/4, 1/4, Sec. T R
12 miles SE, of Lanierville
 (distance) (direction) (Nearest Town)
 (3) Topography: (Hilly) (Flat) (Level)
 (4) Purpose of Well: Domestic
 (Domestic Irrigation
 Municipal, Industrial, Other)

Description & Color of Materials Sand, Clay, Red Clay, Shell, etc.	Thick- ness Feet	Depth Feet
<u>Orange Clay</u>	<u>0</u>	<u>10</u>
<u>Med. Hard Red Clay</u>	<u>10</u>	<u>28</u>
<u>Hard Lignite</u>	<u>28</u>	<u>33</u>
<u>Med. Hard Clay</u>	<u>33</u>	<u>44</u>
<u>Med. Soft Blue Clay</u>	<u>44</u>	<u>60</u>
<u>Blue powder sand</u> <u>+ mica (tight)</u>	<u>60</u>	<u>71</u>

Information upon completion of well:

(1) Diameter 2 inches.
 (2) Total Depth 75 feet.
 (3) Water Level 23 feet below top of ground.
 (4) Cased to 68, Size 2
 (5) Screen: Size 1/4, Length 6'
 (6) Were any formations sealed against pollution?
yes, no.

If YES depth of formation _____
 Why _____
 Drillers Remarks: _____

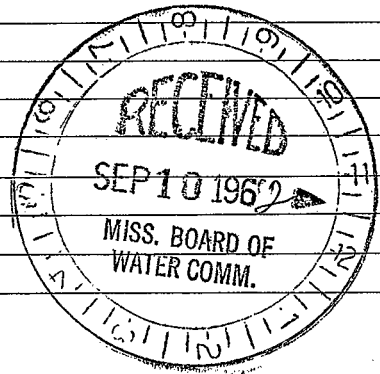

(Use Back Side)

Well No.

