

CODED
6

Q5

WATER WELL DRILLERS LOG

Date: 6-11, 19 64, Driller: MERRITT DAILING County WINSTON
(Name)


(1) Owner of Land: MARUI WILLIAMS
(Name)
Rt. 3 Louisville, Miss
(Address)
(2) Location: 12 13 13 T R
18 miles SE of LOUISVILLE
(distance) (direction) (Nearest Town)
(3) Topography: Hilly
(Hilly) (Flat) (Level)
(4) Purpose of Well: Domestic
(Domestic Irrigation
Municipal, Industrial, Other)

Description & Color of Materials Sand, Clay, Red Clay, Shell, etc.	Thick- ness Feet	Depth Feet
<u>Red CLAY</u>	<u>0</u>	<u>15</u>
<u>Red SAND</u>	<u>15</u>	<u>30</u>
<u>VERY FINE WHITE SAND.</u>	<u>30</u>	<u>185</u>
<u>TAN SAND -</u>	<u>185</u>	<u>147</u>
<u>Rock -</u>	<u>147</u>	

Information upon completion of well:

(1) Diameter 2 inches.
(2) Total Depth 147 feet.
(3) Water Level 30' feet below top of ground.
(4) Cased to 126, Size 2
(5) Screen: Size 1 1/4, Length 6'
(6) Were any formations sealed against pollution?
✓ yes, no.

If YES depth of formation Cemented
Why 16' below top of
ground
Drillers Remarks:

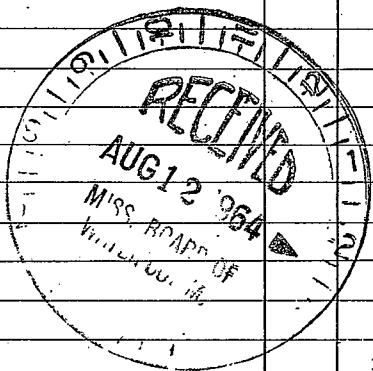

Well No.

(Use Back Side)

1944

1945

1946

1947