

WINSTON
 Q 7
 12-15-72

MISSISSIPPI
 BOARD OF WATER COMMISSIONERS
 416 North State Street
 Jackson, Mississippi 39201

CODED

WATER WELL DRILLERS LOG

12-15-72 date well completed 1972 JH McDonald firm name Winston county well located

LANDOWNER: Mrs Howard
 Louisville Miss
 (mailing address)

description of formations encountered	from	to
Red clay	0	18
white sand	18	42

WELL LOCATION:
 sec. 23 T 13 N S R 13 E W
 (distance) miles (direction) of (nearest town)

WELL PURPOSE: Home
 (home, irrigation, municipal, industrial)

- WELL COMPLETION DATA:
- (1) diameter (inches) 2"
 - (2) total depth (feet) 42
 - (3) static water level (feet) 30 below top of ground.
 - (4) casing steel, 33' (material), (depth)
 2" (size) if telescope see back.
 - (5) screen 5' (length), 40-35 (depth to top)
 1/4" (size), 60 gr. 55 (material)
 - (6) pump 1/2 (HP), 5 (yield gpm)
 electric (type power)
 - (7) electric log no (yes or no)
 - (organization running log)
 - (8) how well bottom plugged


CODED

DRILLERS REMARKS:

JUL 27 1973

If well telescopes please sketch and show depths.

GROUND LEVEL

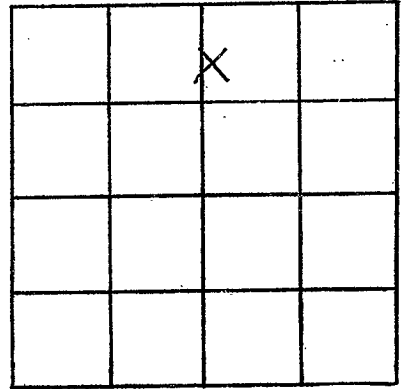

SECTION 23

Please indicate well location X.

ADDITIONAL INFORMATION

If more than one screen, show locations of each on sketch.