

5 BT

CODED

Winston

R 1

11-67

MISSISSIPPI
 BOARD OF WATER COMMISSIONERS
 416 North State Street
 Jackson, Mississippi 39201

WATER WELL DRILLERS LOG

11-3 1967
date well completed

J. H. McDonald
firm name

Winston
county well located

LANDOWNER:

Judith Brown

(mailing address)

description of formations encountered

from to

clay 0' 10'
sand 10' 73'

WELL LOCATION:

sec 27 T. 13 N. R. 14 E. S. W.
22 miles S.E. of Louisville
(distance) (direction) (nearest town)

WELL PURPOSE:

(home, irrigation, municipal, industrial)

WELL COMPLETION DATA:

- (1) diameter (inches) 2"
- (2) total depth (feet) 69'
- (3) static water level (feet) 50' ^{below} _{above} top of ground.
- (4) casing 69' 73' (material) (depth)
none if telescope see back. (size)
- (5) screen 4' (length) (depth to top)
1/4" galvanized steel (size) (material)
- (6) pump 1/2 (HP) 490 gpm (type power) (yield gpm)
Electric
- (7) electric log NO (yes or no)

(organization running log)

(8) how well bottom plugged


DRILLERS REMARKS:

MAY 10 1968

MISS. BD. OF WATER COMM.

If well telescopes please sketch and show depths.

GROUND LEVEL

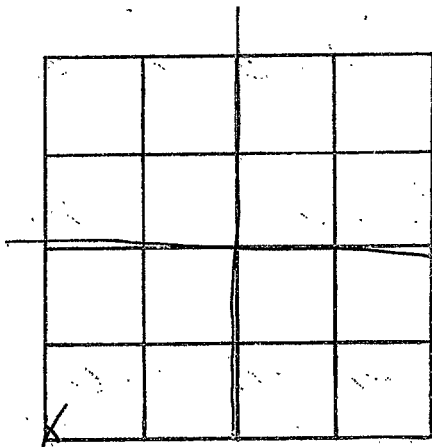

SECTION 27

Please indicate well location X.

ADDITIONAL INFORMATION

If more than one screen,
show locations of each on sketch.