

3 137

CODED

WINSTON
R3
11-67

MISSISSIPPI
BOARD OF WATER COMMISSIONERS
416 North State Street
Jackson, Mississippi 39201

WATER WELL DRILLERS LOG

11-1 1967 *J. J. McDonald* *Winston*
date well completed firm name county well located

LANDOWNER:

Edward Robinson

description of formations encountered

from to

(mailing address)

Gray clay 0 to 60
Sand 60 to 75

WELL LOCATION:

sec. 32 T. 13 N. R. 14 E
S ^W *Frank*
25 1/2 miles SE of Jamison
(distance) (direction) (nearest town)

WELL PURPOSE:

HOME
(home, irrigation, municipal, industrial)

WELL COMPLETION DATA:

- (1) diameter (inches) 2"
- (2) total depth (feet) 75'
- (3) static water level (feet) 55' ^{below} _{above} top of ground.
- (4) casing 66' 75'
(material) (depth)
NONE if telescope see back.
(size)
- (5) screen 4'
(length) (depth to top)
1/4" Stainless Steel
(size) (material)
- (6) pump 3/4" 5
(HP) (yield gpm)
Electric
(type power)
- (7) electric log NO
(yes or no)
- (organization running log)
- (8) how well bottom plugged


DRILLERS REMARKS:

MAY 10 1968

MISS. BD. OF
WATER COMM.

If well telescopes please sketch and show depths.

GROUND LEVEL

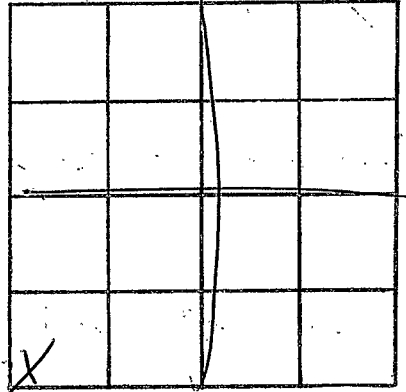

SECTION 3.2

Please indicate well location X.

ADDITIONAL INFORMATION

If more than one screen,
show locations of each on sketch.