

CODED ✓

Winston
R 4
8-24-68

MISSISSIPPI
BOARD OF WATER COMMISSIONERS
416 North State Street
Jackson, Mississippi 39201

WATER WELL DRILLERS LOG

8-24 1968 J. H. McDonald WINSTON
date well completed firm name county well located

LANDOWNER: DONALD LUKE

description of formations encountered	from	to
CLAY		25'
BLUE DIRT	25'	60'
WHITE SAND	60'	75'

LOUISVILLE, MISS.
(mailing address)

WELL LOCATION:
sec. 32 T. 13 N. R. 14 E. S. W.
19 miles S.E. of LOUISVILLE
(distance) (direction) (nearest town)

WELL PURPOSE:
(home, irrigation, municipal, industrial)

WELL COMPLETION DATA:

- (1) diameter (inches) 2"
- (2) total depth (feet) 75'
- (3) static water level (feet) 40' below top of ground.
- (4) casing 2" GAL. 68'
(material) (depth)
- _____ if telescope see back.
(size)
- (5) screen 4' S.S. 72'
(length) (depth to top)
- _____ (size) _____ (material)
- (6) pump 3 H.P. Jet. 6
1/2 (H.P.) (yield gpm)
- ELECTRIC
(type power)
- (7) electric log NO
(yes or no)

_____ (organization running log)

(8) how well bottom plugged _____


DRILLERS REMARKS:

JAN 31 1969

MISS. DD. OR
WATER COMMISSIONERS

If well telescopes please sketch and show depths.

GROUND LEVEL

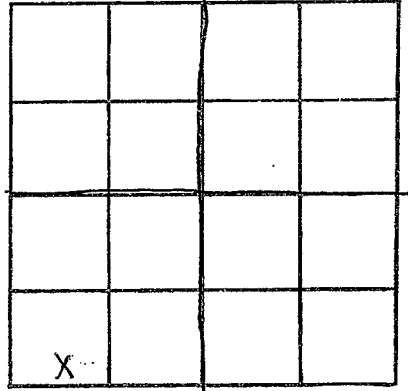

SECTION 32

Please indicate well location X.

ADDITIONAL INFORMATION

If more than one screen, show locations of each on sketch.