

CODED

MISSISSIPPI
BOARD OF WATER COMMISSIONERS
416 North State Street
Jackson, Mississippi 39201

WATER WELL DRILLERS LOG

Winston
R5
11-6-68

11-6-68 19 J. H. McDONALD WINSTON
date well completed firm name county well located

LANDOWNER:

Vernon Mill Pond

description of formations encountered

from to

Louisville, MISS.
(mailing address)

Dry Sand 40'
Coarse Water Sand 40' 73'

WELL LOCATION:

10-11 T. 13 S. R. 14 E. W.
18 miles S.E. of Louisville
(distance) (direction) (nearest town)

WELL PURPOSE: RECREATION
(home, irrigation, municipal, industrial)

WELL COMPLETION DATA:

- (1) diameter (inches) 4"
- (2) total depth (feet) 73'
- (3) static water level (feet) 45' below top of ground.
- (4) casing GALV. 61' (material), (depth)
- 4 (size) if telescope see back.
- (5) screen 10' 73' (length), (depth to top)
- 2" 12 SLOT S.S. (size), (material)
- (6) pump 1 H.P. Sub. 25 (HP), (yield gpm)
- Elec. (type power)
- (7) electric log NO (yes or no)
- (organization running log)
- (8) how well bottom plugged


JAN 31 1969

DRILLERS REMARKS: OUTCROP OF WILCOX STRATTER

MISS. BD. OF WATER COMM.

If well telescopes please sketch and show depths.

GROUND LEVEL

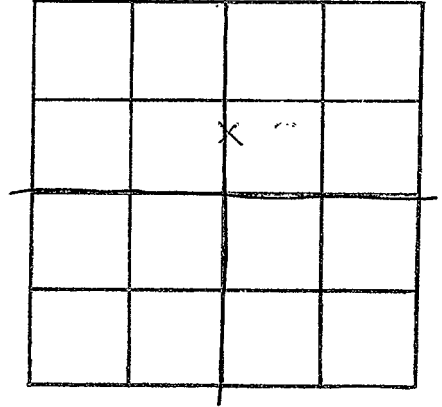

SECTION 10-11

Please indicate well location X.

ADDITIONAL INFORMATION

If more than one screen,
show locations of each on sketch.