

WINSTON  
R 7  
2-5-73

MISSISSIPPI  
BOARD OF WATER COMMISSIONERS  
416 North State Street  
Jackson, Mississippi 39201

**CODED**


WATER WELL DRILLERS LOG

2-5-73 date well completed  
J.H.M. Donald firm name  
Winston county well located

LANDOWNER: <u>Marshall Honore</u> <u>Louisville Miss</u>	description of formations encountered	from	to
(mailing address)	pipe clay	0	25
WELL LOCATION: sec. <u>30</u> T. <u>13</u> (N) R. <u>14</u> (E) S. <u>W</u>	gray clay	25	85
<u>15</u> miles <u>S. E.</u> of <u>Louisville</u> (distance) (direction) (nearest town)	white sand	85	102
WELL PURPOSE: <u>Home</u> (home, irrigation, municipal, industrial)	<b>CODED</b>		
WELL COMPLETION DATA:			
(1) diameter (inches) <u>2</u>			
(2) total depth (feet) <u>102</u>			
(3) static water level (feet) <u>50</u> below top of ground.			
(4) casing <u>steel</u> , <u>98'</u> (material) (depth)			
<u>2"</u> if telescope see back. (size)			
(5) screen <u>4'</u> , <u>102-98'</u> (length) (depth to top)			
<u>1/4"</u> , <u>10 slot 55</u> (size) (material)			
(6) pump <u>1</u> , <u>8</u> (HP) (yield gpm)			
<u>electric</u> (type power)			
(7) electric log _____ (yes or no)			
_____ (organization running log)			
(8) how well bottom plugged _____			
DRILLERS REMARKS: _____	JUL 26 1973		

If well telescopes please sketch and show depths.

GROUND LEVEL

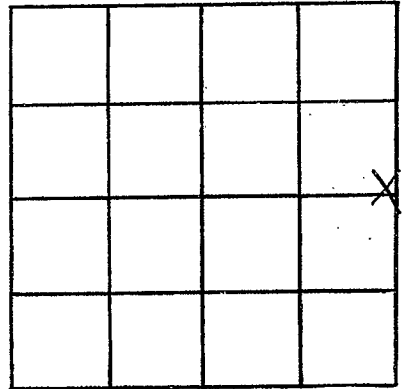

SECTION 30

Please indicate well location X.

ADDITIONAL INFORMATION

If more than one screen,  
show locations of each on sketch.