

**WINSTON**  
~~R 8~~  
**9-5-73**

MISSISSIPPI  
 BOARD OF WATER COMMISSIONERS  
 416 North State Street  
 Jackson, Mississippi 39201

**CODED**

**WATER WELL DRILLERS LOG**

9-5 19 73 J.H. McDonald Winston  
 date well completed firm name county well located

LANDOWNER: Bayne (Graham)  
R. 4  
Louisville Miss  
 (mailing address)

description of formations encountered	from	to
	<u>red clay</u>	<u>0</u>
<u>white gravel</u>	<u>15</u>	<u>40</u>

WELL LOCATION:  
 sec. 20 T. 13 (N) R. 14 (E)  
14 miles S.E. of Louisville  
 (distance) (direction) (nearest town)

WELL PURPOSE: Home  
 (home, irrigation, municipal, industrial)

- WELL COMPLETION DATA:
- (1) diameter (inches) 2"
  - (2) total depth (feet) 140
  - (3) static water level (feet) 28 below top of ground.
  - (4) casing steel 33  
 (material) (depth)  
2" if telescope see back.  
 (size)
  - (5) screen 51 38-33  
 (length) (depth to top)  
1/2" Galv S.S.  
 (size) (material)
  - (6) pump 1 6  
 (HP) (yield gpm)  
electric  
 (type power)
  - (7) electric log no  
 (yes or no)
- (8) how well bottom plugged \_\_\_\_\_  
 (organization running log)


**RECEIVED**

DRILLERS REMARKS:

REC 20 1973  
 MISS. BD. OF WATER COMMISSIONERS

If well telescopes please sketch and show depths.

GROUND LEVEL

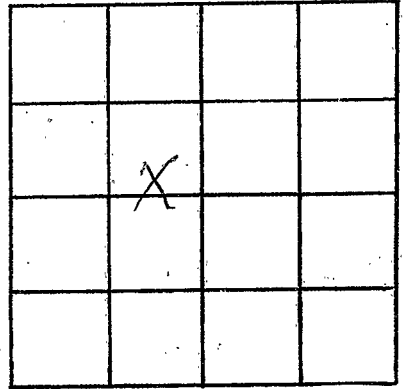

SECTION 20

Please indicate well location X.

ADDITIONAL INFORMATION

If more than one screen, show locations of each on sketch.