

WINSTON
R 10

MISSISSIPPI
BOARD OF WATER COMMISSIONERS CODED
416 North State Street
Jackson, Mississippi 39201

5-30-79

WATER WELL DRILLERS LOG

5-30 1979 J. H. McDonald Winston
date well completed firm name county well located

LANDOWNER: <u>Pilgrimage Rest Church</u> <u>Louisville Miss</u> (mailing address)	description of formations encountered	from	to
	Red Clay	0	20
	gray clay	20	40
	white clay	40	90
	gray clay	90	105
	white sand	105	131

WELL LOCATION:

sec 30 T 13 N R 14 E
S W
14 miles SE of Louisville
(distance) (direction) (nearest town)

WELL PURPOSE: Church
(home, irrigation, municipal, industrial)

WELL COMPLETION DATA:

- (1) diameter (inches) 2"
- (2) total depth (feet) 131
- (3) static water level (feet) 60 below top of ground.
- (4) casing steel, 105 (material) (depth)
- 7" (size) if telescope see back.
- (5) screen 5', 131 126 (length) (depth to top)
- 1/2 10 det SS (size) (material)
- (6) pump 3/4 HP, 5 (HP) (yield gpm)
- electric (type power)
- (7) electric log no (yes or no)
- (organization running log)
- (8) how well bottom plugged


DRILLERS REMARKS:

RECEIVED
AUG 28 1979

MISS. BD. OF WATER COMM.

If well telescopes please sketch and show depths.

GROUND LEVEL

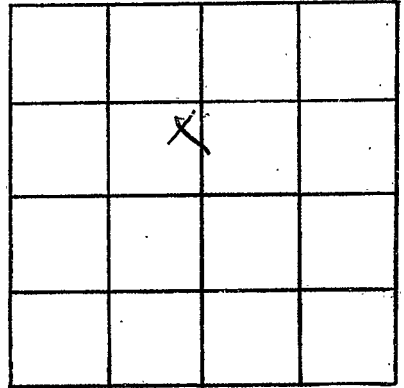

SECTION 30

Please indicate well location X.

ADDITIONAL INFORMATION

If more than one screen, show locations of each on sketch.