

Winston  
R 2000  
3-10-76

MISSISSIPPI  
 BOARD OF WATER COMMISSIONERS  
 416 North State Street  
 Jackson, Mississippi 39201

WATER WELL DRILLERS LOG

3-10 1976 H. McDaniel Winston  
 date well completed firm name county well located


LANDOWNER: Low Fairmont  
Louisville Miss  
 (mailing address)  
 WELL LOCATION:  
 sec 20 T 13 N R 14 E  
1 1/2 miles SE of Wanda  
 (distance) (direction) (nearest town)  
Louisville

description of formations encountered	from	to
<u>red clay</u>	<u>0</u>	<u>25</u>
<u>pipe-sand</u>	<u>25</u>	<u>40</u>
<u>gray clay</u>	<u>40</u>	<u>110</u>
<u>fine sand</u>	<u>110</u>	<u>175</u>
<u>big flat sand</u>	<u>125</u>	<u>180</u>

WELL PURPOSE: Home  
 (home, irrigation, municipal, industrial)

- WELL COMPLETION DATA:
- (1) diameter (inches) 2"
  - (2) total depth (feet) 140
  - (3) static water level (feet) 70 below above top of ground.
  - (4) casing PVC 135  
 (material) (depth)  
2" if telescope see back.  
 (size)
  - (5) screen 5' 140-135  
 (length) (depth to top)  
8 slot 1/2" 5 steel  
 (size) (material)
  - (6) pump 1 8  
 (HP) (yield gpm)  
electric  
 (type power)
  - (7) electric log no  
 (yes or no)
  - (organization running log)
  - (8) how well bottom plugged


DRILLERS REMARKS:

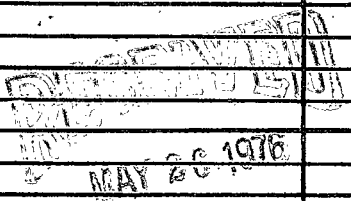

MISS. DE. OF WATER

If well telescopes please sketch and show depths.

GROUND LEVEL

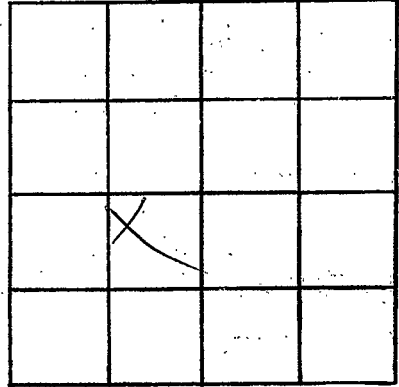

SECTION 20

Please indicate well location X.

ADDITIONAL INFORMATION

If more than one screen, show locations of each on sketch.