

**MISSISSIPPI DEPARTMENT OF ENVIRONMENTAL QUALITY**

Office of Land and Water Resources

P. O. Box 10631  
Jackson, MS 39289-0631  
**WATER WELL DRILLERS LOG**

COUNTY WELL LOCATED <i>Winston Co</i>	
WELL NUMBER <i>R 2002</i>	CODED
DATE WELL COMPLETED <i>Apr. 19 1996</i>	

PERMIT NUMBER
NAME OF DRILLING FIRM <i>Mg water well Drilling Co</i>

NAME & MAILING ADDRESS OF LANDOWNER <i>Bobby Buskirk Preston MS</i>			
WELL LOCATION: SEC TOWNSHIP RANGE <i>26 13 N 14 E</i>			
DISTANCE DIRECTION NEAREST TOWN <i>5 Miles N/E of Preston</i>			
OTHER LANDMARK <i>Handle Com.</i>			
WELL PURPOSE: Home, Irrigation, Municipal, Industrial, Fish Pond, etc. <i>Chicken House Well</i>			

<b>PUMP DATA</b>		
PUMP TYPE (Circle One): <input checked="" type="checkbox"/> Submersible, Turbine, Jet, Flowing Well, Other (Describe) <i>3"</i>		
POWER TYPE (Circle One): <input checked="" type="checkbox"/> Electric, Tractor, Diesel, Gasoline, Butane, Other (Describe) <i>3" H/P 3A</i>		
Pump Capacity (GPM) <i>16</i>	No. of Stages <i>7</i>	Setting Depth <i>90</i> FT.
PUMP TEST Well yielded <i>18</i> GPM with a drawdown of _____ ft. after _____ hours of pumping		

<b>WELL DATA</b>		
Well Depth <i>100'</i>	Casing Diameter (In.) <i>3"</i>	Casing Length (Ft.) <i>90'</i>
Type of Casing <i>PVC</i>	Hole Depth <i>100</i>	Depth to Static Water Level <i>75'</i>
TYPE OF COMPLETION: (Circle One or More): <input checked="" type="checkbox"/> Gravel Packed, Underreamed, Telescoped, Natural Development, Open Hole, Other (Describe) _____		

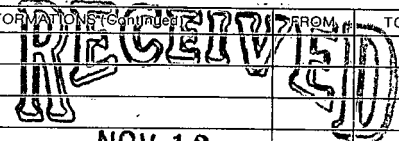
<b>LOG DATA</b>	
TYPE OF LOG RUN (Circle One): No Log Run, Electric, Gamma Ray, Density, Sonic, Neutron, Other (Describe) _____	
Name of Organization Running Log	

WELL GROUTED TO A DEPTH OF _____ FEET
Type Grout (circle one) <input checked="" type="checkbox"/> Cement, Bentonite, or Mix

<b>GEOLOGIC DATA (Office Use Only)</b>			
Surface Elev.	Geologic Unit	Unit Thickness	Depth to Top
Subs. SWL	Date	Analysis	Aquifer Test
Driller's Remarks			
Top of Lap Pipe or Reduction in Casing			
FEET		IF TELESCOPED OR MORE THAN ONE SCREEN: USE BACK PAGE	

<b>SCREEN DATA</b>		
Diameter - Inches <i>3"</i>	Length - Feet <i>10'</i>	Slot Size - Inches <i>#10</i>
Screen Type <i>PVC</i>	Depth to Bottom - Feet <i>100'</i>	

DESCRIPTION OF FORMATIONS ENCOUNTERED	FROM	TO
<i>Top Soil &amp; Clay</i>	<i>1'</i>	<i>18'</i>
<i>Sand</i>	<i>18'</i>	<i>65'</i>
<i>Water Sand</i>	<i>65'</i>	<i>100'</i>

<p align="center">   <b>NOV 12 1996</b>                  Dept. of Environmental Quality                  Office of Land and Water Resources             </p>
IF MORE SPACE IS NEEDED, USE BACK

If well telescopes please  
sketch and show depths.

GROUND LEVEL


SECTION \_\_\_\_\_

Please indicate well location X.

ADDITIONAL INFORMATION

If more than one screen,  
show location of each on sketch.